

KANSAS

FORM 51 5M 1-42 PETROL


Leavenworth

Section 6 Township 10 Range 21E

Well No. #2 Lell Estate

Company Mosbacher

McClouth pool

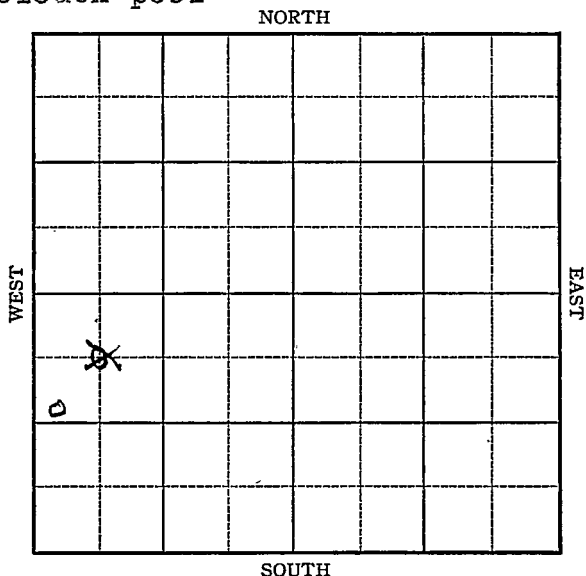

KANSAS

Leavenworth

Sec. 6 Twp. 10 R. 21E

Well No. 2 Bell Estate Farm

Mosbacher Company

( McLouth Pool )

Ft. from N. Line


1575

Ft. from S. Line

Ft. from E. Line

420

Ft. from W. Line

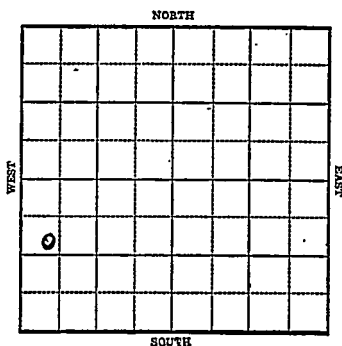

1942

R E P O R T

10/28 10"-551  
Drlg. 534

11/11 Miss. 1430  
T.D. 1438'  
No shows.

**ABANDONED**

KANSAS

Map No. MM Sec. 6 Twp. 10 R. 21EWell No. 2 Bell EstateMosbacher

Company

FIRST REPORT


Contractor

SW NW SW

SECTION PLAT

         Ft. from N. Line1575 Ft. from S. Line         Ft. from E. Line420 Ft. from W. Line

MCLOUTH POOL

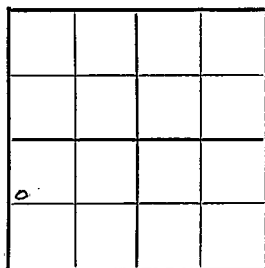Location         Rig up         

Drilling and Remarks:

10" - 55'Drl g. 534

RECORD

Cased          in.,          ft.Sand         Gas         Oil         Total Depth         

PRODUCTION

1st 24 hrs. Nat.         1st 24 hrs. after shot         Gas          Cu. Ft.Dry Hole         Abandoned         

Date

OCT 28 1942 19S. J. LEWIS Scout

KANSAS

Map No. 7/111 Sec. 6 Twp. 10 R. 21EWell No. 2 Bell EstateMosbacher

Company

ABANDONED

Contractor

SW NW SW

## SECTION PLAT

|  |  |  |  |
|--|--|--|--|
|  |  |  |  |
|  |  |  |  |
|  |  |  |  |
|  |  |  |  |

       Ft. from N. Line1575 Ft. from S. Line ,       Ft. from E. Line420 Ft. from W. Line

MCLOUTH POOL

Location                     Rig up                     

Drilling and Remarks:

*Miss 1430**Nos holes*

## RECORD

Cased            in.,            ft.Sand                     Gas                     Oil                     Total Depth 1438

## PRODUCTION

1st 24 hrs. Nat.                     1st 24 hrs. after shot                     Gas                      Cu. Ft.Dry Hole                     Abandoned                     

Date

NOV 11 1942

19

S. J. LEWIS

Scout