

KANSAS

Leavenworth

FORM 51 5M 1-42 PETROL

Section 6 Township 10 Range 21-E

Well No. #3 Bell Estate

Company Chas Miller

NORTH

SOUTH

WEST

EAST

13

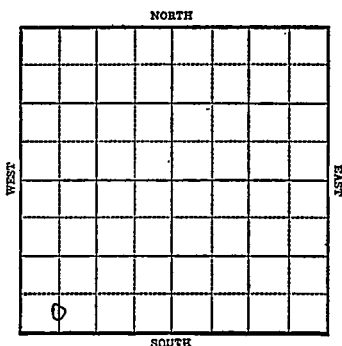
0

KANSAS

Leavenworth

Sec. 6 Twp. 10 R. 21-EWell No. #3 Bell Estate FarmChas Miller Company

McLouth

 Ft. from N. Line330 Ft. from S. Line Ft. from E. Line660 Ft. from W. Line

1943

R E P O R T

4/21 Rigging up material

4/28 10" @ 80'
Drlg. 725'

5/5 1232 SD for 6"

5/12 " " " "

5/19 1356 Run 5"

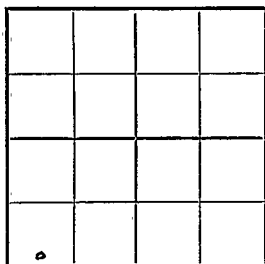
5/26 5" @ 1315
Bart 1352
T.D. 1402-1M gas 100 gqts.

6/2 " " " " 2

6/9 " " " "

6/16 Bart 1352
5" @ 1315'
T.D. 1411'
100 qts.
Pump 30 pot.
Gravity 23.5

COMPLETED

Map No. NM Sec. 6 Twp. 10 R. 21EWell No. 3 Bell EstateChas Miller Company**FIRST REPORT** Contractor**C S $\frac{1}{2}$ SW SW** Ft. from N. Line330 Ft. from S. Line Ft. from E. Line660 Ft. from W. Line**SECTION PLAT****MCLOUTH POOL**Location Rig up

Drilling and Remarks:

Rigging up**Material****RECORD**Cased in., ft.Sand Gas Oil Total Depth **PRODUCTION**1st 24 hrs. Nat. 1st 24 hrs. after shot Gas Cu. Ft.Dry Hole Abandoned

Date

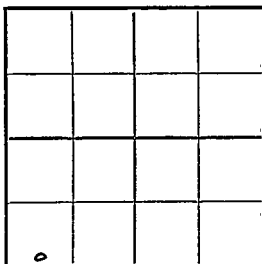
APR 21 1943 19S. J. LEWIS Scout

KANSAS

Leavenworth

Map No. MM Sec. 6 Twp. 10 R. 21EWell No. 3 Bell EstateChas Miller Company**COMPLETED** ContractorC S $\frac{1}{2}$ SW SW Ft. from N. Line330 Ft. from S. Line Ft. from E. Line660 Ft. from W. Line

SECTION PLAT



MCLOUTH POOL

Location Rig up

Drilling and Remarks:

*Bar 81352**510 1315**1009 ft**Pump 80 RY.**235 ft*

RECORD

Cased in., ft.Sand Gas Oil Total Depth 1411

PRODUCTION

1st 24 hrs. Nat. 1st 24 hrs. after shot Gas Cu. Ft.Dry Hole Abandoned

Date

JUN 16 1943 19

S. J. LEWIS Scout