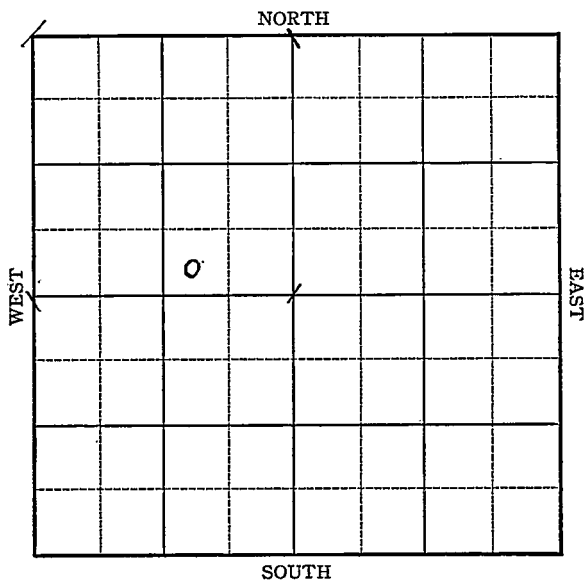


# KANSAS

FORM 51 5M 1-42 PETROL

Leavenworth

Section 6 Township 10 Range 21-EWell No. #1 Kansas City LifeCompany Chas Miller

**KANSAS**

Leavenworth

Sec. 6 Twp. 10 R. 21-E

Well No. #1 Kansas City Life Farm

Chas Miller Company


McLouth

           Ft. from N. Line

330 Ft. from S. Line

990 Ft. from E. Line

           Ft. from W. Line

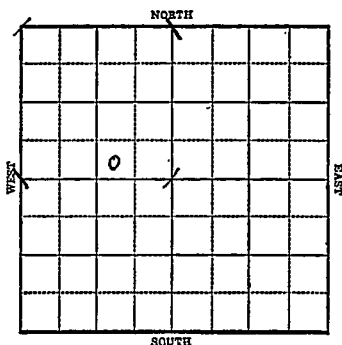

1943

R E P O R T

6/23 Machine  
6/30 "  
7/7 Drlg. 700'  
7/14 Miss. 1448  
T.D. 1480'

**ABANDONED**

**KANSAS****Leavenworth**Map No. W/M Sec. 6 Twp. 10 R. 21EWell No. 1 Kansas City LifeChas Miller

Company

FIRST REPORT

Contractor

**SW SE NW****SECTION PLAT**

Ft. from N. Line


330

Ft. from S. Line

990

Ft. from E. Line

Ft. from W. Line

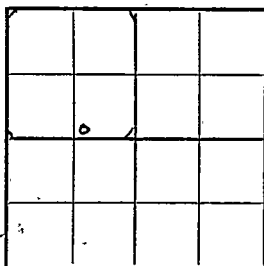**MCLOUTH POOL**

Location

Rig up

Drilling and Remarks:

**Machine****RECORD**Cased          in.,          ft.Sand         Gas         Oil         Total Depth         **PRODUCTION**1st 24 hrs. Nat.         1st 24 hrs. after shot         Gas          Cu. Ft.Dry Hole         Abandoned         

Date

JUN 23 1943 19S. J. LEWIS Scout

**KANSAS****Leavenworth**Map No. MM Sec. 6 Twp. 10 R. 21EWell No. 1 Kansas City LifeChas Miller CompanyABANDONED Contractor

SW SE NW

\_\_\_\_\_ Ft. from N. Line

330 Ft. from S. Line990 Ft. from E. Line

\_\_\_\_\_ Ft. from W. Line

## SECTION PLAT

|  |  |  |  |
|--|--|--|--|
|  |  |  |  |
|  |  |  |  |
|  |  |  |  |
|  |  |  |  |
|  |  |  |  |

**MCLOUTH POOL**

Location \_\_\_\_\_

Rig up \_\_\_\_\_

Drilling and Remarks:

Mws 1448

## RECORD

Cased \_\_\_\_\_ in., \_\_\_\_\_ ft.

Sand \_\_\_\_\_

Gas \_\_\_\_\_

Oil \_\_\_\_\_

Total Depth 1480

## PRODUCTION

1st 24 hrs. Nat. \_\_\_\_\_

1st 24 hrs. after shot \_\_\_\_\_

Gas \_\_\_\_\_ Cu. Ft.

Dry Hole \_\_\_\_\_

Abandoned \_\_\_\_\_

Date

JUL 14 1943

19

S. J. LEWIS

Scout