

# KANSAS


Jefferson

FORM 51 5M 4-41 PETROL

Section 6 Township 10 Range 20-E

Well No. 1 Woodhead Est.

Company Anderson et al

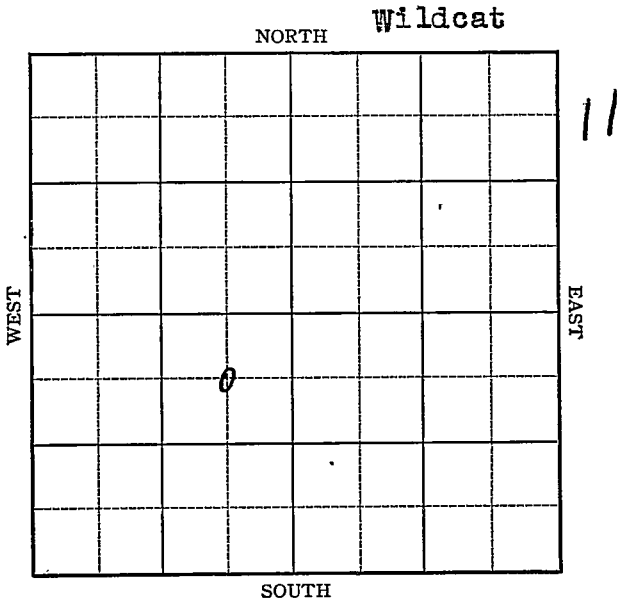

Sec. 6 Twp. 10 R. 20-E


Well No. #1 Woodhead Est. Farm  
Anderson et al Company  
**(Wildcat)**

660 Ft. from N. Line

\_\_\_\_\_ Ft. from S. Line

660 Ft. from E. Line

\_\_\_\_\_ Ft. from W. Line

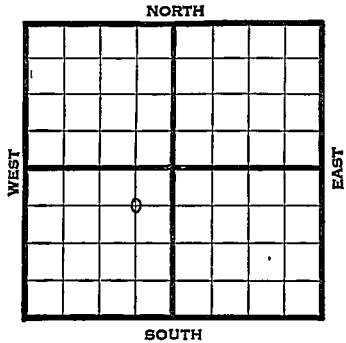

	REPORT
1941	
8/13	10" - 37
	Drlg. 530'
8/21	Drlg. 1372'
8/28	Bart. 1529-40 $\frac{1}{2}$ ' T.D.
	40 qts. 1528 $\frac{1}{2}$ -40 $\frac{1}{2}$ '
	Shut down. No casing.
9/3	Bart. 1529'
	T.D. 1540 $\frac{1}{2}$ '
	Shot 40 qts. 1528 $\frac{1}{2}$ -40 $\frac{1}{2}$ '
	No shows.
	<b>ABANDONED</b>

**KANSAS**

Jefferson

Map No. NM Sec. 6 Twp. 10 R. 20EWell No. 1 Woodhead Est.Anderson etal

Company

Contractor

**FIRST REPORT**

C NE SW

660 Ft. from N. Line

Ft. from S. Line

660 Ft. from E. Line

Ft. from W. Line

**SECTION PLAT**

	o		

WILDCAT

Location \_\_\_\_\_

Rig up \_\_\_\_\_

Drilling and Remarks:

10" - 37Drlg. 530**RECORD**

Cased \_\_\_\_\_ in., \_\_\_\_\_ ft.

Sand \_\_\_\_\_

Gas \_\_\_\_\_

Oil \_\_\_\_\_

Total Depth \_\_\_\_\_

**PRODUCTION**

1st 24 hrs. Nat. \_\_\_\_\_

1st 24 hrs. after shot \_\_\_\_\_

Gas \_\_\_\_\_ Cu. Ft.

Dry Hole \_\_\_\_\_

Abandoned \_\_\_\_\_

Date

AUG 13 1941S. J. LEWIS

Scout

Map No. \_\_\_\_\_ Sec. 6 Twp. 10 R. 20E

Well No. 1 Woodhead Est.

Anderson etal Company

ABANDONED Contractor

C NE SW

660 Ft. from N. Line

\_\_\_\_\_ Ft. from S. Line

660 Ft. from E. Line

\_\_\_\_\_ Ft. from W. Line

**SECTION PLAT**

	0		

**WILDCAT**

Location \_\_\_\_\_

Rig up \_\_\_\_\_

Drilling and Remarks:

*Bar 8 1529*  
*40 gts 1528 1/2 - 40 1/2*  
*Noa hooa*

**RECORD**

Cased \_\_\_\_\_ in., \_\_\_\_\_ ft.

Sand \_\_\_\_\_

Gas \_\_\_\_\_

Oil \_\_\_\_\_

Total Depth 1540 1/2

**PRODUCTION**

1st 24 hrs. Nat. \_\_\_\_\_

1st 24 hrs. after shot \_\_\_\_\_

Gas \_\_\_\_\_ Cu. Ft.

Dry Hole: \_\_\_\_\_

Abandoned \_\_\_\_\_

Date

SEP 3 1941 19

S. J. LEWIS Scout