


15027 00022 0300

Form 51-5M-7-25-19786

Map No. **KANSAS** Sec. **7** Twp. **10** R. **4-E**Well No. **1 - Fading** Farm
Henderson - Holden & Vickers, Pet. Company

NORTH

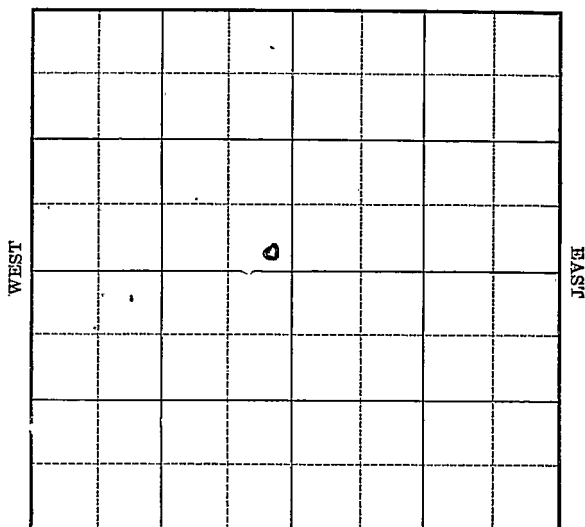

SOUTH

Location _____

Drilling Remarks _____

Rig Up _____

Drilling Remarks _____

RECORD

Cased _____ in. _____ ft.

Sand _____

Gas _____

Oil _____

Total Depth _____

PRODUCTION

1st 24 hrs. Nat. _____

1st 24 hrs. after shot _____

Gas _____ cu. ft.

Dry Hole _____

Abandoned _____

Clay Co

Map No. Kansas Sec. 7 Twp. 10 R. 4EWell No. 1 Fadley FarmHenderson-Holden & Vickers Company
Per

NORTH

WEST

EAST

SOUTH

_____ Ft. from N. Line

250 Ft. from S. Line250 Ft. from E. Line

_____ Ft. from W. Line

REPORT

Date

19261/141/201/272/42/102/112/243/53/103/18SpuddingDlg 1500'Abandoned 2070

Clay Co
 Map No. **KANSAS** Sec. *7* Twp. *10* R. *4* ^E

Well No. *1* *Fadbury*
Henderson-Holmes & Vickers Oil Co Company

Contractor

FIRST REPORTS

SECTION PLAT

_____ Ft. from N. Line

250 Ft. from S. Line

250 Ft. from E. Line

_____ Ft. from W. Line

Location _____

Rig up _____

Drilling and Remarks:

Spudding

RECORD

Cased _____ in., _____ ft.

Sand _____

Gas _____

Oil _____

Total Depth _____

PRODUCTION

1st 24 hrs. Nat. _____

1st 24 hrs. after shot _____

Gas _____ Cu. Ft.

Dry Hole _____

Abandoned _____

Date

JAN 14 1926

CHAS. L. SHERWOOD

192 Scout

Returned.....

Cards.....

Tracing.....

France Map.....

Scarborough Map.....

Moody Map.....

Scarborough Plat Book.....

Moody Plat Book.....

no tracing

newall map

N.W. Map

no 1172 map

no map **KANSAS**Map No. 7 Sec. 7 Twp. 10 R. 2Well No. 1 Fadley
Henderson - Holder & Dickers Let Company

Contractor

COMPLETED

SECTION PLAT

Ft. from N. Line

750

Ft. from S. Line

750

Ft. from E. Line

Ft. from W. Line

ABANDONED

Location

Rig up

Drilling and Remarks:

Dry & hard

2 D 2070'

D.F.H.

RECORD

Cased _____ in., _____ ft.

Sand _____

Gas _____

Oil _____

Total Depth 2070'

PRODUCTION

1st 24 hrs. Nat. _____

1st 24 hrs. after shot _____

Gas _____ Cu. Ft.

Dry Hole ☒Abandoned ☒

Date

MAR 18 1926

CHAS. L. SHERWOOD

192

Scout

Returned	
Cards	<i>15</i>
Tracing	<i>10</i>
France Map	☒
Scarborough Map	☒
Moody Map	☒
Scarborough Plat Book	
Moody Plat Book	

No Wall Map
No Small map

MAP No. _____ SEC. 7 TWP. 10S R. 4EWELL No. 1 FaddenHanerson & Chisum COMPANY_____
CONTRACTOR

SECTION PLAT

Ft. FROM N. LINE_____
Ft. FROM S. LINE_____
Ft. FROM E. LINE_____
Ft. FROM W. LINE

LOCATION _____

RIG UP _____

DRILLING AND REMARKS:

H. J. H.

RECORD

CASED _____ IN. _____ FT.

SAND _____

GAS _____

OIL _____

TOTAL DEPTH 2070

PRODUCTION

1ST 24 HRS. NAT. _____

1ST 24 HRS. AFTER SHOT _____

GAS _____ Cu. Ft.

DRY HOLE ☒ABANDONED ☒

DATE

3/18/6

192

SCOUT