

KANSAS

Leavenworth

FORM 51 5M PETROL

Section 7 Township 10 Range 21-E

Well No. #4 Jim Bell

Company Chas. Miller

NORTH

	0						

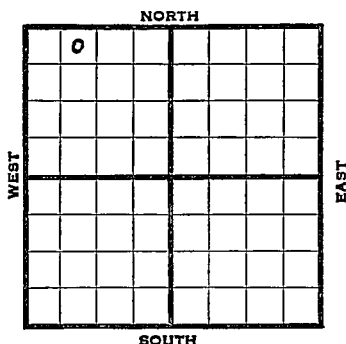
SOUTH

WEST

EAST

4

KANSAS

Sec. 7 Twp. 10 R. 21-EWell No. #4 Jim Bell FarmChas. Miller Company330 Ft. from N. Line Ft. from S. Line Ft. from E. Line990 Ft. from W. Line

1943

REPORT

9/1

Location

9/8

Spud

9/15

10" @ 24

BKC 649

8" @ 823

Sand 1329

6" @ 1329

T.D. 1335- 1½ M Gas

9/22

Sand 1329

6" @ 1329

6 M. Gas

T.D. 1352'

COMPLETED

KANSAS

Map No. NM Sec. 7 Twp. 10 R. 21EWell No. 114 Jim BellChas. Miller

Company

FIRST REPORT

Contractor

NE NW NW

330

Ft. from N. Line

Ft. from S. Line

Ft. from E. Line

990

Ft. from W. Line

SECTION PLAT

o			

McLouth Pool

Location X

Rig up

Drilling and Remarks:

RECORD

Cased _____ in., _____ ft.

Sand _____

Gas _____

Oil _____

Total Depth _____

PRODUCTION

1st 24 hrs. Nat. _____

1st 24 hrs. after shot _____

Gas _____ Cu. Ft.

Dry Hole _____

Abandoned _____

Date

SEP 1 1943S. J. LEWIS Scout

KANSAS

Map No. NM Sec. 7 Twp. 10 R. 21EWell No. 4 Jim BellChas. Miller Company

COMPLETED

Contractor

NE NW NW

330 Ft. from N. Line

Ft. from S. Line

Ft. from E. Line

990 Ft. from W. Line

SECTION PLAT

0			

McLouth Pool

Location

Rig up

Drilling and Remarks:

Land 1/3296" @ 13296M Gas

RECORD

Cased _____ in., _____ ft.

Sand _____

Gas _____

Oil _____

Total Depth 1352

PRODUCTION

1st 24 hrs. Nat. _____

1st 24 hrs. after shot _____

Gas _____ Cu. Ft.

Dry Hole _____

Abandoned _____

Date

SEP 22 1943 19 S. J. LEWIS Scout