

KANSAS

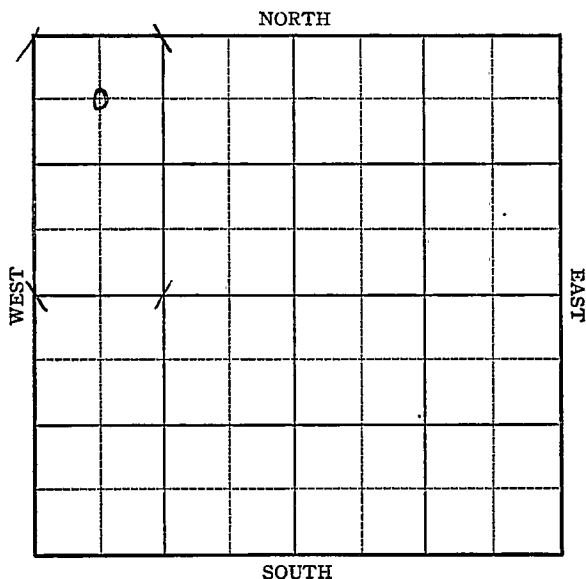
Leavenworth

FORM 51 5M 10-41 PETROL

Section 7 Township 10 Range 21-E

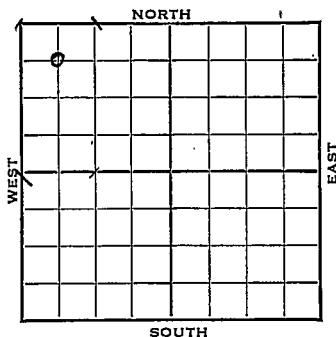
Well No. #1 Bell

Company C. E. Miller



Sec. 7 Twp. 10 R. 21-EWell No. #1 Bell FarmC. E. Miller Company

McLouth Pool

660 Ft. from N. Line Ft. from S. Line Ft. from E. Line660 Ft. from W. Line

1943

REPORT

1/6

Machine

1/13

10" casing set 25'

Drlg. 520'

1/20

8" Casing set 899'

Sand 1378

6" Casing set 1378'

TD 1384'

Estimate $7\frac{1}{2}$ M Gas/

1/27

" " "

2/3

sand 1372

6" casing set 1372'

T.D. 1384'

 $8\frac{1}{2}$ M gas.

COMPLETED

KANSASMap No. MM Sec. 7 Twp. 10 R. 21EWell No. 1 BellC. E. Miller

Company

FIRST REPORT

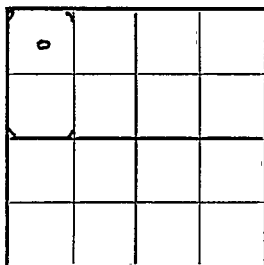
Contractor

C NW NW

SECTION PLAT660 Ft. from N. Line

Ft. from S. Line

Ft. from E. Line

660 Ft. from W. Line**MCLOUTH POOL**

Location

RECORD

Rig up

Drilling and Remarks:

Machine

Cased _____ in., _____ ft.

Sand _____

Gas _____

Oil _____

Total Depth _____

PRODUCTION

1st 24 hrs. Nat. _____

1st 24 hrs. after shot _____

Gas _____ Cu. Ft.

Dry Hole _____

Abandoned _____

Date

JAN 6 1943

19

S. J. LEWIS

Scout

Leavenworth

KANSAS

Map No. W M Sec. 7 Twp. 10 R. 21EWell No. 1 Bell

C. E. Miller

Company

COMPLETED

Contractor

C NW NW

SECTION PLAT

660 Ft. from N. Line

Ft. from S. Line

Ft. from E. Line

660 Ft. from W. Line

0			

MCLOUTH POOL

Location

Rig up

Drilling and Remarks:

*Canol 1372**6 "C 1372**8 1/4 M Gas*

RECORD

Cased _____ in., _____ ft.

Sand _____

Gas _____

Oil _____

Total Depth 1384

PRODUCTION

1st 24 hrs. Nat. _____

1st 24 hrs. after shot _____

Gas _____ Cu. Ft.

Dry Hole _____

Abandoned _____

Date

FEB 3 1943

S. J. LEWIS Scout