


Section 7 ~ Township 10 Range 21-E

Well No. #1 Jeannine

Company J. V. Schafges & Anderson

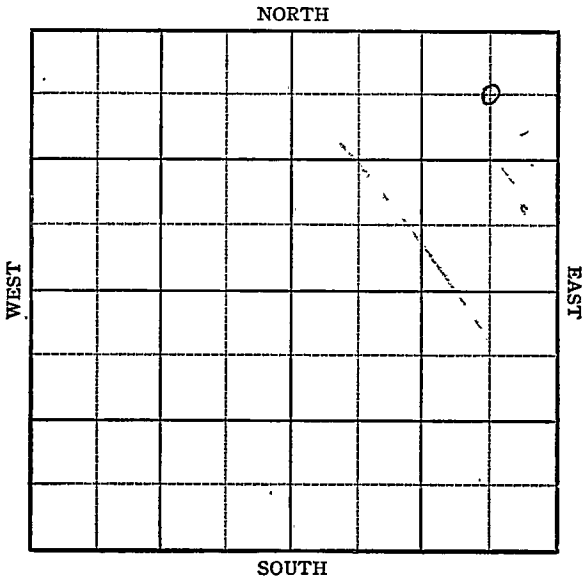


KANSAS

Sec. 7 Twp. 10 R. 21-E

Well No. #1 Jeannine Farm

J. V. Schafges & Anderson Company

NORTH

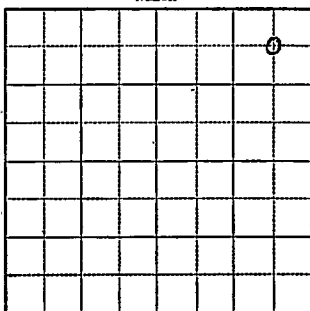

660 Ft. from N. Line

Ft. from S. Line

660 Ft. from E. Line

Ft. from W. Line

Elev. 1029

SOUTH

1943

R E P O R T

9/29 Cable rig.

19/6 " "

10/13 10" @ 26'  
B Hertq 675

10/20 8" @ 825  
Drlg. 960'  
Miss 1450'  
6" @ 1409  
No show  
T.D. 1454'


ABANDONED

KANSAS

Map No. NW Sec. 7 Twp. 10 R. 21EWell No. 1 JeannineJ. V. Schefges & Anderson CompanyFIRST REPORT Contractor

C NE NE

## SECTION PLAT

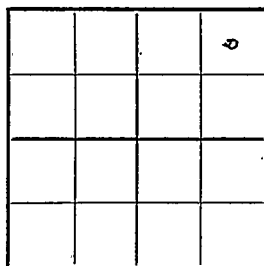660 Ft. from N. Line         Ft. from S. Line660 Ft. from E. Line         Ft. from W. Line

McLouth Pool

Location         Rig up         

Drilling and Remarks:

Cable Rig

## RECORD

Cased          in.,          ft.Sand         Gas         Oil         Total Depth         

## PRODUCTION

1st 24 hrs. Nat.         1st 24 hrs. after shot         Gas          Cu. Ft.Dry Hole         Abandoned         

Date

SEP 29 1943 19 S. J. LEWIS Scout

**KANSAS**Map No. 111 Sec. 7 Twp. 10 R. 21EWell No. 1 JeannineJ. V. Schafges & Anderson  
Company**ABANDONED**

Contractor

**C NE NE**660 Ft. from N. Line

Ft. from S. Line

660 Ft. from E. Line

Ft. from W. Line

**SECTION PLAT**

|  |  |  |   |
|--|--|--|---|
|  |  |  | o |
|  |  |  |   |
|  |  |  |   |
|  |  |  |   |

**McLouth Pool**

Location \_\_\_\_\_

Rig up \_\_\_\_\_

Drilling and Remarks:

*Miss 1450**6 "C 1409**No show***RECORD**

Cased \_\_\_\_\_ in., \_\_\_\_\_ ft.

Sand \_\_\_\_\_

Gas \_\_\_\_\_

Oil \_\_\_\_\_

Total Depth 1454**PRODUCTION**

1st 24 hrs. Nat. \_\_\_\_\_

1st 24 hrs. after shot \_\_\_\_\_

Gas \_\_\_\_\_ Cu. Ft.

Dry Hole \_\_\_\_\_

Abandoned \_\_\_\_\_

Date

OCT 20 1943

19

S. J. LEWIS Scout