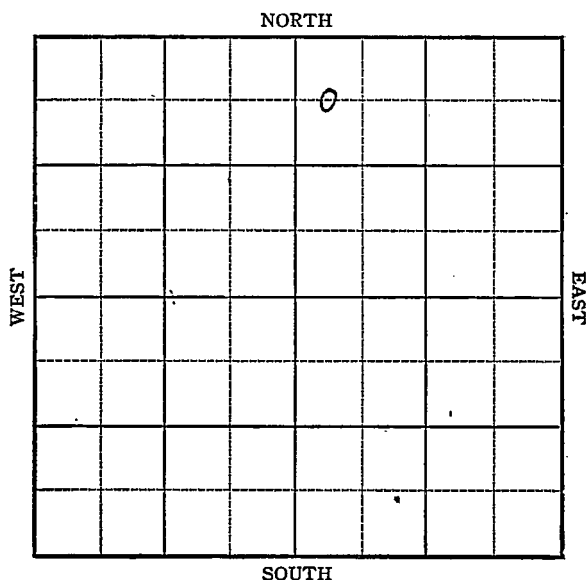


KANSAS


FORM 51 5M PETROL

Leavenworth

Section 8 Township 10 Range 21-EWell No. #1 p. W. FarrerCompany Wilson et al

KANSAS

Leavenworth

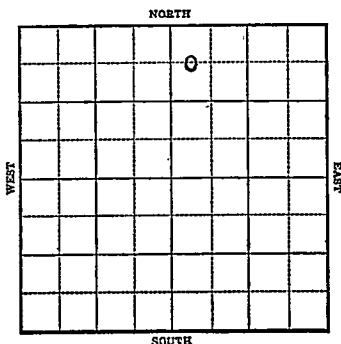Sec. 8 Twp. 10 R. 21-EWell No. #1 P. W. Farrar FarmWilson etal Company660 Ft. from N. Line Ft. from S. Line Ft. from E. Line330 Ft. from W. LineElev 954

1943

R E P O R T

9/29

Cable

10/6

"

10/13

B. Herta 567

8" @ 773

Drlg. 810'

10/20

Miss 325

T D. 1376

ABANDONED

~~KANSAS~~
 Map No. ~~7718~~ Sec. 8 Twp. 10 R. 21E


Well No. 1 P. W. Farrer

Wilson et al. Company

FIRST REPORT Contractor

C W L NW NE

SECTION PLAT

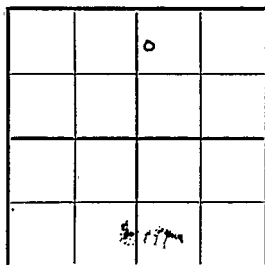

660 Ft. from N. Line

Ft. from S. Line

Ft. from E. Line

330 Ft. from W. Line

McLouth Pool

Location

Rig up

Drilling and Remarks:

Cable

RECORD

Cased in. ft.

Sand

Gas

Oil

Total Depth

PRODUCTION

1st 24 hrs. Nat.

1st 24 hrs. after shot

Gas Cu. Ft.

Dry Hole

Abandoned

Date

SEP 29 1943 19

S. J. LEWIS Scout

KANSAS

Map No. 1111 Sec. 8 Twp. 10 R. 21EWell No. 1 P. W. BarrarWilson et al. CompanyABANDONED Contractor

C W L NW NE

660 Ft. from N. Line Ft. from S. Line Ft. from E. Line330 Ft. from W. Line

SECTION PLAT

		0	

McLouth PoolLocation Rig up

Drilling and Remarks:

Miss 1325

RECORD

Cased in ft.Sand Gas Oil Total Depth 1376

PRODUCTION

1st 24 hrs. Nat. 1st 24 hrs. after shot Gas Cu. Ft.Dry Hole Abandoned

Date

OCT 20 1943 19S. J. LEWIS Scout