

KANSAS


FORM 51 5M 1-42 PETROL

Leavenworth

Section 8 Township 10 Range 21-E

Well No. #1 Summers

Company ~~McLaughlin~~ MCGUIRE

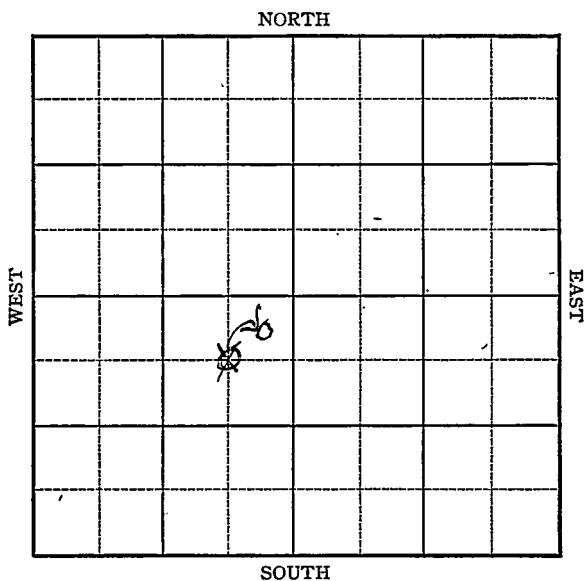

KANSAS

Sec. 8 Twp. 10 R. 21-EWell No. #1 Summers FarmMcGUIRE
McLaughlin

Company

330~~660~~


Ft. from N. Line

Ft. from S. Line

330~~660~~

Ft. from E. Line

Ft. from W. Line

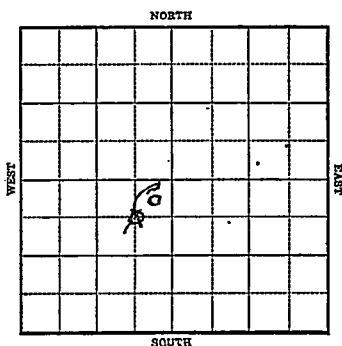

1944

R E P O R T

1-19

Machine

1/26

"

2/2

Drlg. 900'

2/8

" "

2/15

Miss!415

TD 1419

ABANDONED

KANSAS

Map No. 1111 Sec. 8 Twp. 10 R. 21EWell No. 1 Summers

McLaughlin


Company

FIRST REPORT

Contractor

C NE SW

SECTION PLAT

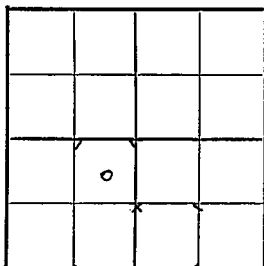660 Ft. from N. Line Ft. from S. Line660 Ft. from E. Line Ft. from W. Line

McLouth Pool

Location Rig up

Drilling and Remarks:

Machine

RECORD

Cased in., ft.Sand Gas Oil Total Depth

PRODUCTION

1st 24 hrs. Nat. 1st 24 hrs. after shot Gas Cu. Ft.Dry Hole Abandoned

Date

JAN 19 1944

19

S. J. LEWIS

Scout

Map No. KANSAS Sec. 8 Twp. 10 R. 21E
 Well No. 1 Summers

McGuire & Tal.

Company

CORRECTION

Contractor

NE SW

SECTION PLAT

330

Ft. from N. Line

Ft. from S. Line

330

Ft. from E. Line

Ft. from W. Line

	o		

McLouth Pool

Location

Rig up

Drilling and Remarks:

Reported as

McLaughlin

C NE NW

RECORD

Cased _____ in., _____ ft.

Sand _____

Gas _____

Oil _____

Total Depth _____

PRODUCTION

1st 24 hrs. Nat. _____

1st 24 hrs. after shot _____

Gas _____ Cu. Ft.

Dry Hole _____

Abandoned _____

Date

FEB 2 1944

19

S. J. LEWIS

Scout

Map No. KANCA 8 Sec. 8 Twp. 10 R. 21E

Well No. 1 Summers

McGuire et al.

Company

ABANDONED

Contractor

NE SW


SECTION PLAT

330 Ft. from N. Line

Ft. from S. Line

330 Ft. from E. Line

Ft. from W. Line

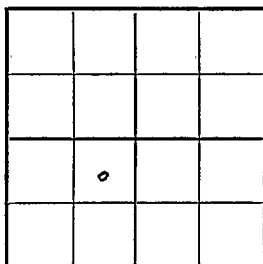

McLouth Pool

Location

Rig up

Drilling and Remarks:

W 1415

RECORD

Cased in. ft.

Sand

Gas

Oil

Total Depth 1419

PRODUCTION

1st 24 hrs. Nat.

1st 24 hrs. after shot

Gas Cu. Ft.

Dry Hole

Abandoned

Date

FEB 16 1944 19

S. J. LEWIS Scout