


Section 8 Township 10 Range 20-E

Well No. 1 McLeod

Company McLaughlin et al

NORTH Miscellaneous

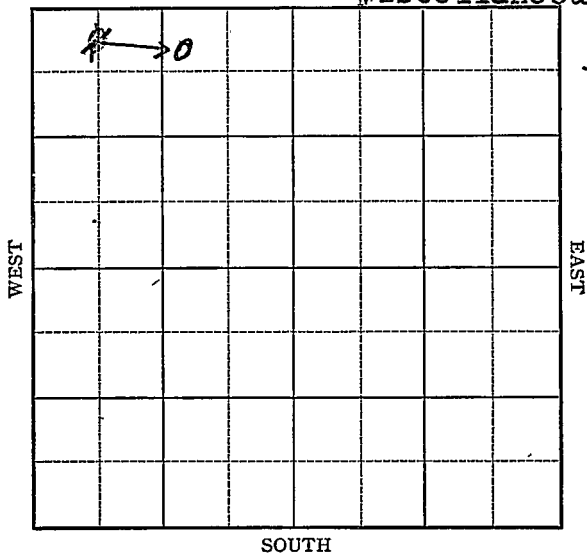

Sec. 8 Twp. 10 R. 20-E

Well No. #1 McLeod Farm

McLaughlin et al Company


(Misc.)

~~330~~ 460 Ft. from N. Line

\_\_\_\_\_ Ft. from S. Line

1080 Ft. from E. Line

~~660~~ \_\_\_\_\_ Ft. from W. Line

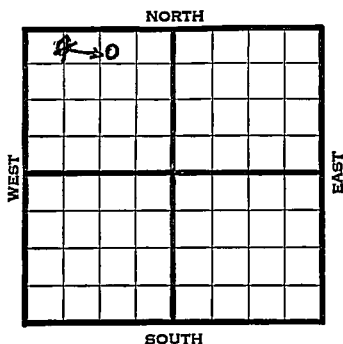

1941	REPORT
9/1	Machine.
10/9	Spud 150'
10/16	12" - 86' 10" - 122'
	Drlg. 165'
10/23	Drlg. 735'
10/30	SD 1100'
11/6	Miss. 1469' T.D. 1552'
	6" - 1550' WOC.
11/12	Bart. 1550'
	6" - 1551'
	T.D. 1571'
	17,800,000 cu. ft. gas.
	424# rock pressure.
	<b>COMPLETED</b>

Map No. 100 Sec. 8 Twp. 10 R. 20E

Well No. 1 McLeod

McLaughlin etal Company

Contractor

**FIRST REPORT**

**SECTION PLAT**

C NL NW NW

330 Ft. from N. Line

\_\_\_\_\_ Ft. from S. Line

\_\_\_\_\_ Ft. from E. Line

660 Ft. from W. Line

0			

**MISCELLANEOUS**

Location \_\_\_\_\_

Rig up \_\_\_\_\_

Drilling and Remarks:

Machine

**RECORD**

Cased \_\_\_\_\_ in., \_\_\_\_\_ ft.

Sand \_\_\_\_\_

Gas \_\_\_\_\_

Oil \_\_\_\_\_

Total Depth \_\_\_\_\_

**PRODUCTION**

1st 24 hrs. Nat. \_\_\_\_\_

1st 24 hrs. after shot \_\_\_\_\_

Gas \_\_\_\_\_ Cu. Ft.

Dry Hole \_\_\_\_\_

Abandoned \_\_\_\_\_

Date

OCT 1 1941 19

S. J. LEWIS Scout

Jefferson

KANSAS

Map No. NM Sec. 8 Twp. 10 R. 20EWell No. 1 McLeodMcLaughlin etal CompanyCORRECTION Contractor

NW NE NW

460 Ft. from N. Line

\_\_\_\_\_ Ft. from S. Line

1080 Ft. from E. Line

\_\_\_\_\_ Ft. from W. Line

MISCELLANEOUS

## SECTION PLAT

	0		

Location \_\_\_\_\_

Rig up \_\_\_\_\_

Drilling and Remarks:

Reported

C NL NW NW

## RECORD

Cased \_\_\_\_\_ in., \_\_\_\_\_ ft.

Sand \_\_\_\_\_

Gas \_\_\_\_\_

Oil \_\_\_\_\_

Total Depth \_\_\_\_\_

## PRODUCTION

1st 24 hrs. Nat. \_\_\_\_\_

1st 24 hrs. after shot \_\_\_\_\_

Gas \_\_\_\_\_ Cu. Ft.

Dry Hole \_\_\_\_\_

Abandoned \_\_\_\_\_

Date

OCT 15 1941 19 \_\_\_\_\_ S. J. LEWIS Scout

Map No. MM Sec. 8 Twp. 10 R. 20EWell No. 1 McLeodMcLaughlin et al. CompanyCOMPLETED Contractor

NW NE NW

460 Ft. from N. Line

\_\_\_\_\_ Ft. from S. Line

1080 Ft. from E. Line

\_\_\_\_\_ Ft. from W. Line

## SECTION PLAT

	6		

## MISCELLANEOUS

Location \_\_\_\_\_

Rig up \_\_\_\_\_

Drilling and Remarks:

Bar 815506" @ 155117,500,000 cu ft  
gas.424 # Rock Pt.

## RECORD

Cased \_\_\_\_\_ in., \_\_\_\_\_ ft.

Sand \_\_\_\_\_

Gas \_\_\_\_\_

Oil \_\_\_\_\_

Total Depth 1571

## PRODUCTION

1st 24 hrs. Nat. \_\_\_\_\_

1st 24 hrs. after shot \_\_\_\_\_

Gas \_\_\_\_\_ Cu. Ft.

Dry Hole \_\_\_\_\_

Abandoned \_\_\_\_\_

Date

NOV 12 1941

19

S. J. LEWIS Scout