

# KANSAS


Jefferson

FORM 51 5M 4-41 PETROL

Section 8 Township 10 Range 20E

Well No. 1-Van Druff

Company Mosbacher

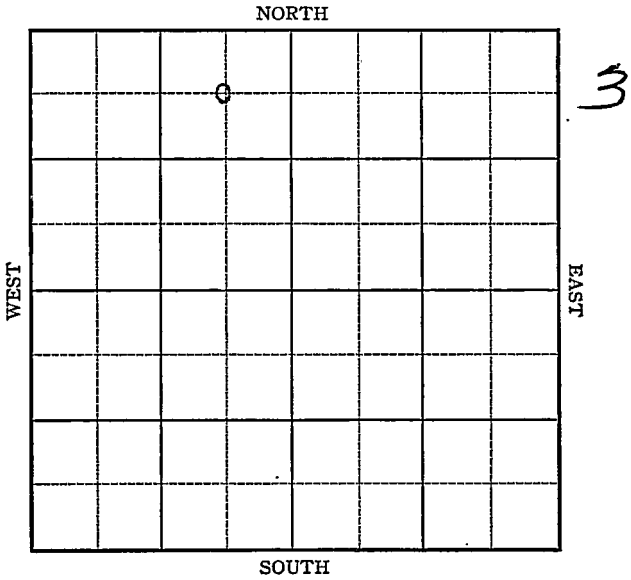



Map No. \_\_\_\_\_ Sec. 8 Twp. 10 R. 20EWell No. 1 VanDruffMosbacher

Company

**FIRST REPORT**

Contractor

C NE NW


430 Ft. from N. Line

\_\_\_\_\_ Ft. from S. Line

750 Ft. from E. Line

\_\_\_\_\_ Ft. from W. Line

## SECTION PLAT

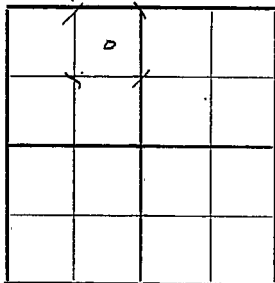

MISCELLANEOUS

Location \_\_\_\_\_

Rig up \_\_\_\_\_

Drilling and Remarks:

Spud 120'

## RECORD

Cased \_\_\_\_\_ in., \_\_\_\_\_ ft.

Sand \_\_\_\_\_

Gas \_\_\_\_\_

Oil \_\_\_\_\_

Total Depth \_\_\_\_\_

## PRODUCTION

1st 24 hrs. Nat. \_\_\_\_\_

1st 24 hrs. after shot \_\_\_\_\_

Gas \_\_\_\_\_ Cu. Ft.

Dry Hole \_\_\_\_\_

Abandoned \_\_\_\_\_

Date

SEP 3 1941 19

S. I. LEWIS Scout

Map No. MM Sec. 8 Twp. 10 R. 20E

Well No. 1 VanDruff

Mosbacher Company

COMPLETED Contractor

C NE NW

**SECTION PLAT**

430 Ft. from N. Line

\_\_\_\_\_ Ft. from S. Line

750 Ft. from E. Line

\_\_\_\_\_ Ft. from W. Line

	o		

**MISCELLANEOUS**

Location \_\_\_\_\_

Rig up \_\_\_\_\_

Drilling and Remarks:

*Bar 71503  
6" @ 1503  
13,200,000 cu ft  
gas*

**RECORD**

Cased \_\_\_\_\_ in., \_\_\_\_\_ ft.

Sand \_\_\_\_\_

Gas \_\_\_\_\_

Oil \_\_\_\_\_

Total Depth 1525

**PRODUCTION**

1st 24 hrs. Nat. \_\_\_\_\_

1st 24 hrs. after shot \_\_\_\_\_

Gas \_\_\_\_\_ Cu. Ft.

Dry Hole \_\_\_\_\_

Abandoned \_\_\_\_\_

Date

SEP 24 1941 19

S. J. LEWIS

Scout