


Section 9 Township 10 Range 19-E

Well No. #1 Leonhard

Company Sifers etal
(Misc.)

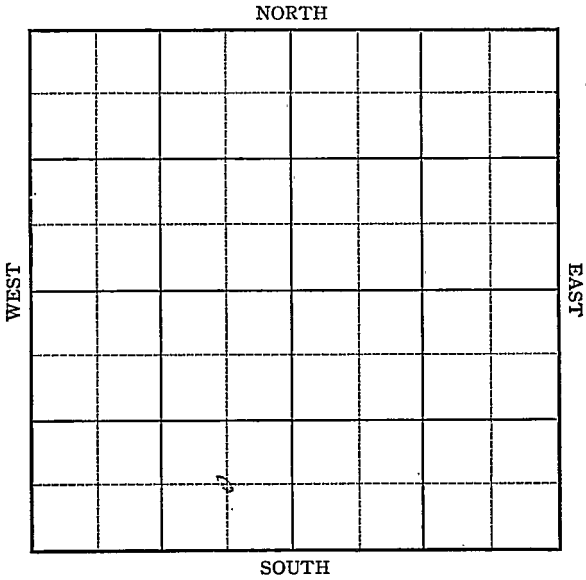

Sec. 9 Twp. 10 R. 19-E

Well No. #1 Leonhard Farm


Sifers et al Company
(Miscellaneous)

 Ft. from N. Line

660 Ft. from S. Line

660 Ft. from E. Line

 Ft. from W. Line

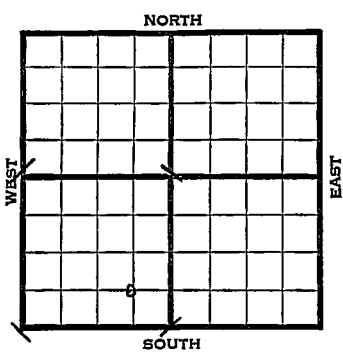

1941	REPORT
8/6	Cable
8/15	Cable rig.
8/21	10" - 78' Drlg. 375'
8/28	Drlg. 630'
9/4	SD 696'
9/11	Drlg. 705'
9/18	SD 842'
9/25	"
10/2	"
10/9	"
10/16	"
10/23	"
10/30	SD 920'
11/6	"
11/13	"
11/20	SD 1010'
11/26	"
12/4	Drlg. 1283'
12/11	6" @ 984 TD 1430 NR 6"
12/18	1350 WR 6"
12/24	" "
12/31	Fsg. 1430' OVER

1942			
1/8	SD	1430'	
1/15	"		
1/22	"		
1/29	"		
2/5	"		
2/12	"		
2/19	"		
2/26	"		
3/5	"		
3/11	T.D.	1430'	
	Drlg. up bailer.		
3/19	"	"	"
3/26	"	"	"
4/2	Shut down.		
4/8	"	"	
4/15	"	"	
4/22	"	"	
4/29	"	"	
5/6	"	"	
5/13	"	"	
5/20	"	"	
5/27	"	"	
6/3	"	"	
6/10	T.D.	1444'	

ABANDONED

Map No. MM Sec. 9 Twp. 10 R. 19E

Well No. 1 Leonhard

Sifers etal. Company

ABANDONED Contractor

C SE SW

SECTION PLAT

_____ Ft. from N. Line

660 Ft. from S. Line

660 Ft. from E. Line

_____ Ft. from W. Line

MISCELLANEOUS

Location _____

Rig up _____

Drilling and Remarks:

RECORD

Cased _____ in., _____ ft.

Sand _____

Gas _____

Oil _____

Total Depth 1444

PRODUCTION

1st 24 hrs. Nat. _____

1st 24 hrs. after shot _____

Gas _____ Cu. Ft.

Dry Hole _____


Abandoned _____

Date

JUN 1 0 1942 19

S. J. LEWIS

Scout

 


Misc Small Maps	X
Cards	<i>Paul</i>
Tracing	
France Map	
Scarborough Map	X
Moody Map	
Geological Dept.	
Moody Flat Book	

KANSASMap No. NM Sec. 9 Twp. 10 R. 19EWell No. 1 LeonhardSifers etal Company~~FIRST REPORT~~ Contractor

C SE SW

 Ft. from N. Line660 Ft. from S. Line660 Ft. from E. Line Ft. from W. Line

SECTION PLAT

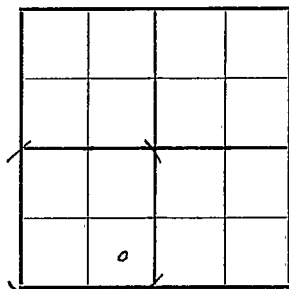

MISCELLANEOUS

RECORD

Location Cased in., ft.Rig up Sand

Drilling and Remarks:

Gas Cable †Oil Total Depth

PRODUCTION

1st 24 hrs. Nat. 1st 24 hrs. after shot Gas Cu. Ft.Dry Hole Abandoned

Date

AUG 6 1941S. J. LEWIS Scout

Misc Small Maps

Cards *One*

Tracing

France Map

Scarborough Map

Moody Map

Geological Dept.

Moody Flat Book ...