


KANSAS

Leavenworth

Section 9 Township 10 Range 21-E


Well No. #1 Bank

Company McLaughlin

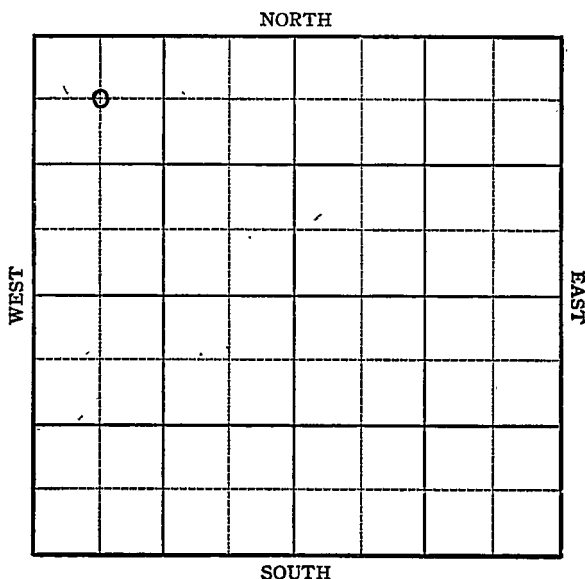

KANSAS

Leavenworth

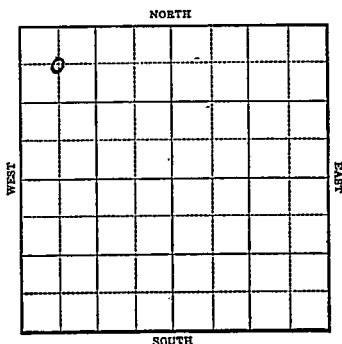Sec. 9 Twp. 10 R. 21-EWell No. #1 Bank FarmMcLaughlin Company660 Ft. from N. Line Ft. from S. Line Ft. from E. Line660 Ft. from W. LineElev. 933

1943

R E P O R T

9/8 Machine
9/15 10" @ 40'
Drlg. 360'
9/22 Drlg. 705'
9/29 Samd 1278
Miss 1343
Drlg. 1410
10/6 T.D. 1460' SD
10/13 Miss 1343
HPW
T.D. 1460'

ABANDONED

Map No. MM Sec. 9 Twp. 10 R. 21E

Well No. 1 Bank

McLaughlin

Company

FIRST REPORT

Contractor

C NW NW

660 Ft. from N. Line

_____ Ft. from S. Line

_____ Ft. from E. Line

660 Ft. from W. Line

McLouth Pool

SECTION PLAT

<u>0</u>			

Location _____

Rig up _____

Drilling and Remarks:

Machine

RECORD

Cased _____ in., _____ ft.

Sand _____

Gas _____

Oil _____

Total Depth _____

PRODUCTION

1st 24 hrs. Nat. _____

1st 24 hrs. after shot _____

Gas _____ Cu. Ft.

Dry Hole _____

Abandoned _____

Date

SEP 8 1943 19

S. J. LEWIS Scout

KANSAS

Map No. MM Sec. 9 Twp. 10 R. 21E

Well No. 1 Bank

McLaughlin Company

ABANDONED Contractor

C NW NW


SECTION PLAT

660 Ft. from N. Line

 Ft. from S. Line

 Ft. from E. Line

660 Ft. from W. Line

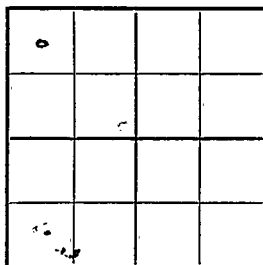

McLouth Pool

Location

Rig up

Drilling and Remarks:

Wichita 1373

CHFW

RECORD

Cased in., ft.

Sand

Gas

Oil

Total Depth 1460

PRODUCTION

1st 24 hrs. Nat.

1st 24 hrs. after shot

Gas Cu. Ft.

Dry Hole

Abandoned

Date

OCT 13 1943 19

S. J. LEWIS Scout