

KANSAS

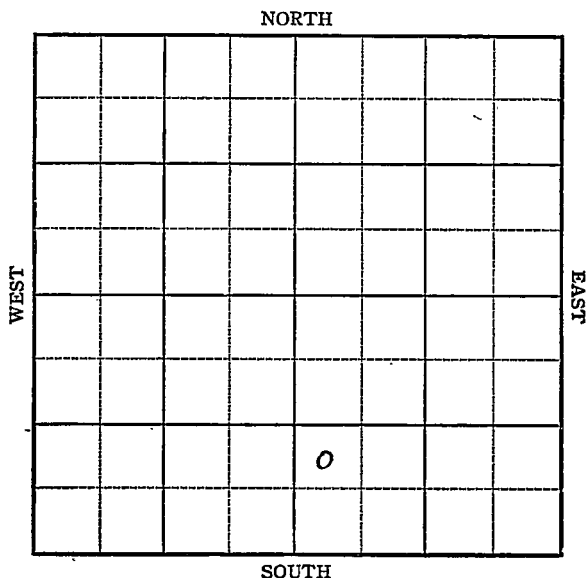
Leavenworth

FORM 51 5M PETROL

Section 9 Township 10 Range 21E

Well No. #1 Lolar

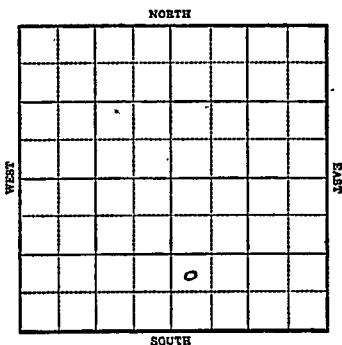
Company Sherrod et al.



245 880

Sec. 9 Twp. 10 R. 21EWell No. #1 Lolar FarmSherrod etal Company

McLouth

 Ft. from N. Line990 Ft. from S. Line Ft. from E. Line330 Ft. from W. Line

1944

R E P O R T

2/16

10" - 30'

8" - 632

6" - 1183

Miss. - 1254

Drlg. - 1320

2/23

Miss 1254'

TD 1401

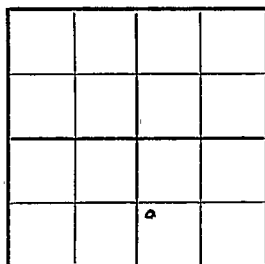
ABANDONED

KANSAS

Map No. 1111 Sec. 9 Twp. 10 R. 21EWell No. 1 LolarSherrod et al. CompanyFIRST REPORT Contractor

NW SW SE

SECTION PLAT

 Ft. from N. Line990 Ft. from S. Line Ft. from E. Line330 Ft. from W. LineMcLouth PoolLocation Rig up

Drilling and Remarks:

10" - 30'

8" - 632

6" - 1183

Miss. 1254

Drlg. 1320

RECORD

Cased in., ft.Sand Gas Oil Total Depth

PRODUCTION

1st 24 hrs. Nat. 1st 24 hrs. after shot Gas Cu. Ft.Dry Hole Abandoned

Date

FEB 16 1944 19 S. J. LEWIS Scout

KANSAS

Map No. NM Sec. 9 Twp. 10 R. 21EWell No. 1 Lolar

Sherrod et al.

Company

ABANDONED

Contractor

NW SW SE

SECTION PLAT

Ft. from N. Line

990

Ft. from S. Line

Ft. from E. Line

330

Ft. from W. Line

McLouth Pool

Location

Rig up

Drilling and Remarks:

Miss 1254

RECORD

Cased _____ in., _____ ft.

Sand _____

Gas _____

Oil _____

Total Depth 1401

PRODUCTION

1st 24 hrs. Nat. _____

1st 24 hrs. after shot _____

Gas _____ Cu. Ft.

Dry Hole _____

Abandoned _____

Date

FEB 23 1944 19

S. J. LEWIS Sco