

KANSAS

Leavenworth


FORM 51 5M PETROL

Section 9 Township 10 Range 21E

Well No. #2 Metropolitan Life

Company Sherrod et al.

McLouth Pool

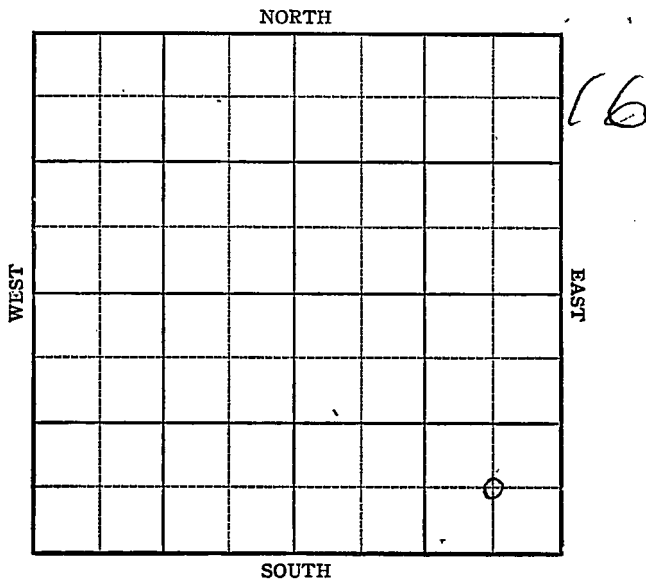


KANSAS

Leavenworth

Sec. 9 Twp. 10 R. 21-EWell No. #2, Metropolitan Life Farm
Sherrod et al. Company

NORTH

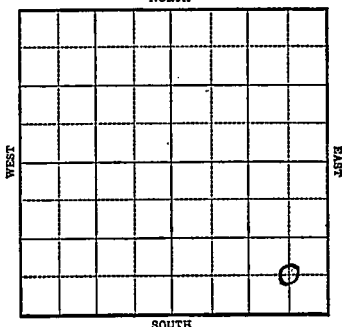

SOUTH

 Ft. from N. Line660 Ft. from S. Line660 Ft. from E. Line Ft. from W. Line

REPORT

1943
12/15 Machine
12/22 Spud
12/29 Spud 35' SD
1944
1-5 Drlg 247'
1-12 Sand 1213'
6" @ 1212 WOC
1/19 " " "
1/26 " " "
2/2 Miss 1306
TD 1315

ABANDONED

KANSAS
 Map No. 1272 Sec. 9 Twp. 10 R. 21E

Well No. 2 Metropolitan Life

Sherrod et al. Company

FIRST REPORT Contractor

C SE SE

SECTION FLAT

 Ft. from N. Line

660 Ft. from S. Line

660 Ft. from E. Line

 Ft. from W. Line

			o

McLouth Pool

Location

Rig up

Drilling and Remarks:

Machine

RECORD

Cased in., ft.

Sand

Gas

Oil

Total Depth

PRODUCTION

1st 24 hrs. Nat.

1st 24 hrs. after shot

Gas Cu. Ft.

Dry Hole

Abandoned

Date

DEC 15 1943

19

S. J. LEWIS Scout

no wall - - - f

No Small map Omaha

cc. 5. 27"
Card, *Madge*

cc. 100

France 1. 1. 2

Spencer 1. 1. 2

Moody 1. 1. 2

Geological 1. 1. 2

Moody Plat. Boo'

X

Map No. ~~KANSAS~~ Sec. 9 Twp. 10 R. 21E

Well No. 2 Metropolitan Life

Sherrod et al.

Company

ABANDONED

Contractor

C SE SE

SECTION PLAT

			o

Ft. from N. Line

660

Ft. from S. Line

660

Ft. from E. Line

Ft. from W. Line

McLouth Pool

Location

Rig up

Drilling and Remarks:

Wire 1306

RECORD

Cased _____ in., _____ ft.

Sand _____

Gas _____

Oil _____

Total Depth 1315

PRODUCTION

1st 24 hrs. Nat. _____

1st 24 hrs. after shot _____

Gas _____ Cu. Ft.

Dry Hole _____

Abandoned _____

Date

FEB 2 1944 19

S. J. LEWIS Scout

no well

Misc. Small Maps

Cards *Mudge*

Tracing

France Map

Scarborough Map

Moody Map

Geological Dept.

Moody Plat Book

No Small map - Anna

HB