

KANSAS


Leavenworth

15 103 00006 0000
FORM 51 5M 1-42 PETROL

Section 9 Township 10 Range 21E

Well No. #1 Murphy

Company McLaughlin

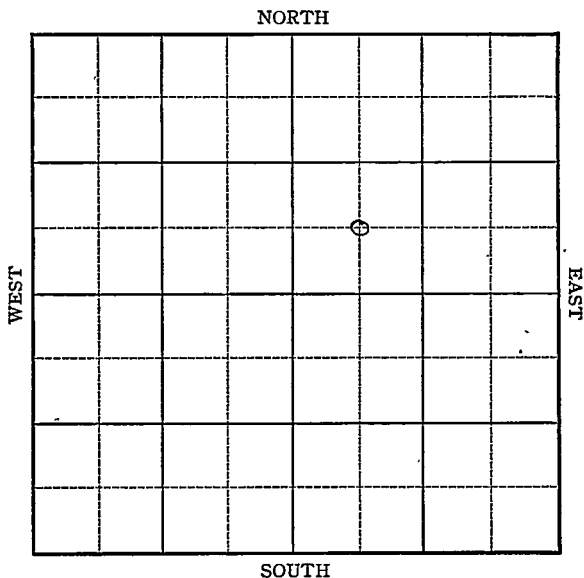

~~Leavenworth~~


Leavenworth

Sec. 9 Twp. 10 R. 21E

Well No. # 1 Murphy Farm
McLaughlin Company

Leavenworth

NORTH

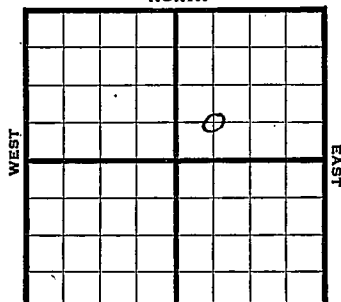

 Ft. from N. Line

660 Ft. from S. Line

 Ft. from E. Line

660 Ft. from W. Line

1944

R E P O R T

5/10	Loc
5/17	Machine
5/24	"
5/31	"
6/7	"
6/15	8" @ 605 S.GAS 1015-65- 6" @ 1148 TD 1283
6/21	TD 1283 HR 8"
6/28	PB
7/19	Miss. 1281 TD 1283

ABANDONED

Pool Name McLouth

KANSAS

Map No. N/M Sec. 9 Twp. 10 R. 21EWell No. 1 MurphyMcLaughlin CompanyABANDONED Contractor

C SW NE

SECTION PLAT

 Ft. from N. Line660 Ft. from S. Line Ft. from E. Line660 Ft. from W. Line

		o	

Leavenworth CountyLocation Rig up

Drilling and Remarks:

Miss 1281

RECORD

Cased in., ft.Sand Gas Oil Total Depth 1283

PRODUCTION

1st 24 hrs. Nat. 1st 24 hrs. after shot Gas Cu. Ft.Dry Hole Abandoned

Date

JUL 1 9 1944 19S. J. LEWIS Scout

Misc. Small Maps

Cards *Betty*

Tracing

France Map

Scarborough Map

Woodsy Map

Zoological Dept.

Wood's Plat Book

No Small Map - *Anna*

KANSAS

Pool Name LeavenworthMap No. N 14 Sec. 9 Twp. 10 R. 21EWell No. 1 MurphyMcLaughlin

Company

FIRST REPORT

Contractor

C SW NE

SECTION PLAT

		o	

 Ft. from N. Line660 Ft. from S. Line Ft. from E. Line660 Ft. from W. LineLeavenworth CountyLocation XRig up

Drilling and Remarks:

RECORD

Cased in., ft.Sand Gas Oil Total Depth

PRODUCTION

1st 24 hrs. Nat. 1st 24 hrs. after shot Gas Cu. Ft.Dry Hole Abandoned

Date

MAY 10 1944 19S. J. LEWIS Scout

No Wall map

Misc. Small Maps	
Cards	<i>See for</i>
Tracing	
France Map	<i>X</i>
Scarborough Map	<i>X</i>
Moody Map	
Geological Dept.	
Moody Plat Book	

No Small map - Anna

AM