

KANSAS


Leavenworth

FORM 51 5M PETROL

Section 9 Township 10 Range 21E

Well No. #1 Murphy

Company McGuire et al

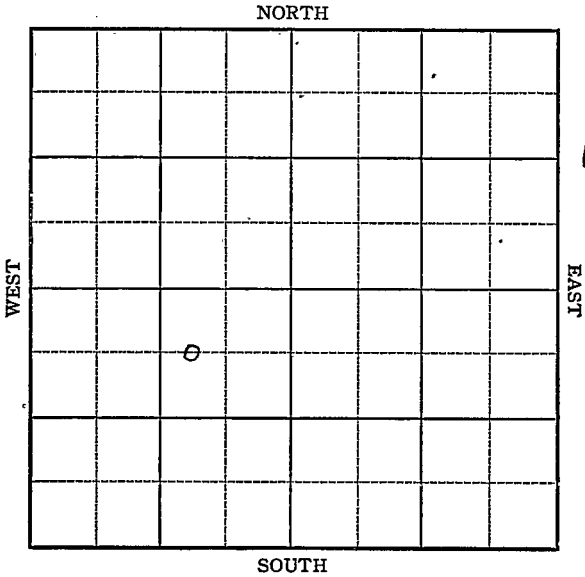

KANSAS

Leavenworth

Sec. 9 Twp. 10 R. 21-E

Well No. #1 Murphy Farm


McGuire etal Company

660 Ft. from N. Line

 Ft. from S. Line

990 Ft. from E. Line

 Ft. from W. Line

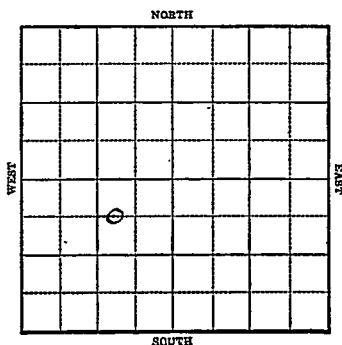

1943

R E P O R T

12/ 1 Machine
12/8 "
12-15 Drlg. 100"
12/22 10" @ 40
Drlg. 275'
12/29 Drlg. 455'
1944
1-5 Drlg 735'
1/12 6" @ 1232
Sand 1234
TD 1256
15 M. Gas

COMPLETED

KAY'S

Map No. MM Sec. 9 Twp. 10 R. 21EWell No. 1 MurphyMcGuire et al.


Company

FIRST REPORT

Contractor

C W L NE SW

SECTION PLAT

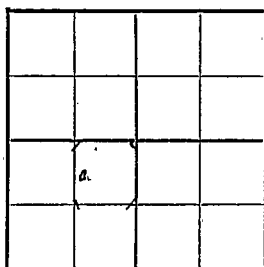660 Ft. from N. Line Ft. from S. Line990 Ft. from E. Line Ft. from W. Line

McLouth Pool

Location

Rig up

Drilling and Remarks:

Machine

RECORD

Cased in ft.

Sand

Gas

Oil

Total Depth

PRODUCTION

1st 24 hrs. Nat.

1st 24 hrs. after shot

Gas Cu. Ft.

Dry Hole

Abandoned

Date

DEC 1 1943 19

S. J. LEWIS

Scout




KANSAS

Map No. 111 Sec. 9 Twp. 10 R. 21EWell No. 1 MurphyMcGuire et al.

-Company

COMPLETED

Contractor

C W L NE SW

SECTION PLAT

660


Ft. from N. Line

Ft. from S. Line

990

Ft. from E. Line

Ft. from W. Line

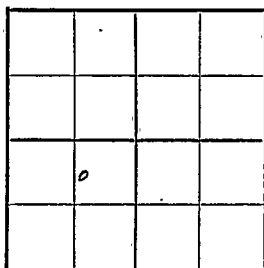McLouth Pool

Location

Rig up

Drilling and Remarks:

*Sand 1234**6 "C/1232**15M Gas*

RECORD

Cased _____ in., _____ ft.

Sand _____

Gas _____

Oil _____

Total Depth 1256

PRODUCTION

1st 24 hrs. Nat. _____

1st 24 hrs. after shot _____

Gas _____ Cu. Ft.

Dry Hole _____

Abandoned _____

Date

JAN 12 1944 19

S. J. LEWIS

Scout

no wall

Misc. Small Maps

Cards

Tracing

France Map

Scarborough Map

Moody Map

Ceological Dept.

Moody Plat Book

No small mag-Oma

Madge

X

MB