



Map No. **KANSAS** Sec. 24 Twp. 11 R. 10


Well No. 1 - Jones Farm  
Doric O.G. Company

250 Ft. from N. Line

\_\_\_\_\_ Ft. from S. Line

250 Ft. from E. Line

\_\_\_\_\_ Ft. from W. Line

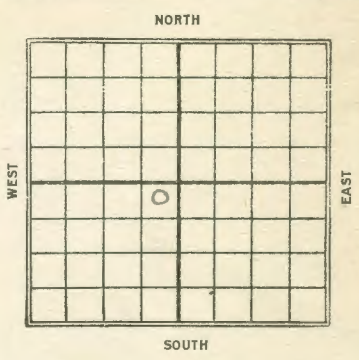

1928

Date	REPORT
<u>2/9</u>	<u>S.D. 1530</u>
<u>2/16</u>	<u>7/19</u>
<u>2/23</u>	<u>7/26</u>
<u>3/1</u>	<u>8/2</u>
<u>3/8</u>	<u>8/9</u>
<u>3/16</u>	<u>8/16</u>
<u>3/22</u>	<u>8/23</u>
<u>3/29</u>	<u>8/28</u>
<u>4/5</u>	<u>9/4</u>
<u>4/12</u>	<u>9/12</u>
<u>4/19</u>	<u>9/19</u>
<u>4/26</u>	<u>9/26</u>
<u>5/3</u>	<u>10/3</u>
<u>5/10</u>	<u>10/10</u>
<u>5/18</u>	<u>10/17</u>
<u>5/24</u>	<u>10/24</u>
<u>5/31</u>	<u>10/31</u>
<u>6/7</u>	<u>11/7</u>
<u>6/14</u>	<u>11/14</u>
<u>6/21</u>	<u>11/21</u>
<u>6/28</u>	<u>11/28</u>
<u>7/6</u>	<u>12/5</u>
<u>7/13</u>	

12/12 - T.D. 1530'

12/19 \_\_\_\_\_

12/26 \_\_\_\_\_

1929

1/2 \_\_\_\_\_

1/9 \_\_\_\_\_

1/16 \_\_\_\_\_

1/23 \_\_\_\_\_

1/30 \_\_\_\_\_

2/6 \_\_\_\_\_

2/13 \_\_\_\_\_

2/20 \_\_\_\_\_

2/27 \_\_\_\_\_

3/6 \_\_\_\_\_

3/13 \_\_\_\_\_

3/20 \_\_\_\_\_

3/27 \_\_\_\_\_

4/3 \_\_\_\_\_

4/10 \_\_\_\_\_

4/17 \_\_\_\_\_

4/24 \_\_\_\_\_

5/1 \_\_\_\_\_

5/8 - No report

5/15 \_\_\_\_\_ 8/17 \_\_\_\_\_

5/22 \_\_\_\_\_ 8/14 \_\_\_\_\_

5/29 \_\_\_\_\_ 8/21 \_\_\_\_\_

6/5 \_\_\_\_\_ 8/28 \_\_\_\_\_

6/12 \_\_\_\_\_ 9/4 \_\_\_\_\_

6/19 \_\_\_\_\_ 9/11 \_\_\_\_\_

6/26 \_\_\_\_\_ 9/18 \_\_\_\_\_

7/2 \_\_\_\_\_ 9/25 \_\_\_\_\_

7/10 \_\_\_\_\_ 10/2 \_\_\_\_\_

7/17 \_\_\_\_\_ 10/9 \_\_\_\_\_

7/24 \_\_\_\_\_ 10/16 - T.D. 1530'

7/31 \_\_\_\_\_ Dry & Abandon

Wabamsee E

Map No. **KANSAS** Sec. **24** Twp. **11** R. **10**

Well No. **1 Jones**

**Done 075**

Company

Contractor

**COMPLETE**

SECTION PLAT

**750** Ft. from N. Line

Ft. from S. Line

**750** Ft. from E. Line

Ft. from W. Line

	0		

**ABANDONED**

Location

Rig up

Drilling and Remarks:

RECORD

Cased in, ft.

Sand

Gas

Oil

Total Depth **1530**

PRODUCTION

1st 24 hrs. Nat.

1st 24 hrs. after shot

Gas Cu. Ft.

Dry Hole

Abandoned

Date

**OCT 16 1929**

192

**CHAS. L. SHERWOOD**

Scout

Map No. *KANSAS* Sec. *24* Twp. *11* R. *10* <sup>E</sup>

Well No. *1 Jones*

*Doric Oil & Gas Co* Company

Contractor

**FIRST REPORTS**

*250* Ft. from N. Line

Ft. from S. Line

*250* Ft. from E. Line

Ft. from W. Line

**SECTION PLAT**

	o		

Location

Rig up

Drilling and Remarks:

*S/D 1530'*

**RECORD**

Cased in., ft.

Sand

Gas

Oil

Total Depth

**PRODUCTION**

1st 24 hrs. Nat.

1st 24 hrs. after shot

Gas Cu. Ft.

Dry Hole

Abandoned

Date **FEB 9 1928**

**CHAS. L. SHERWOOD**