


KANSAS

Section 6 Township 11 Range 10-E
 Well No. #1 Sherman Mertz
 Company Amerado

NORTH

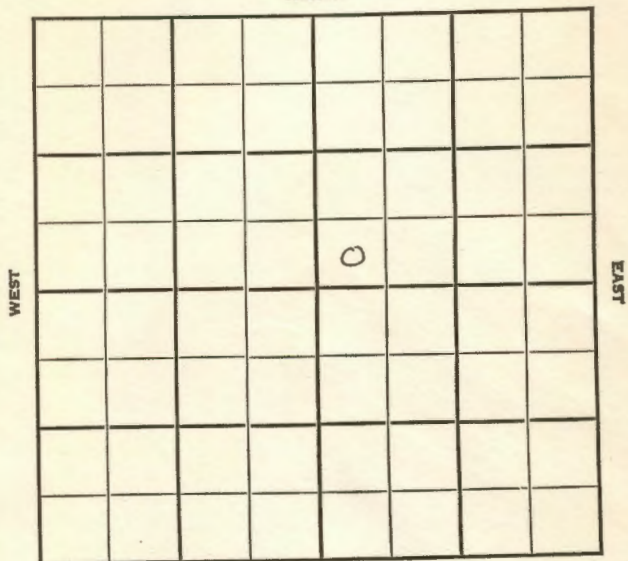

SOUTH

KANSAS

Wabunsee

Sec. 6 Twp. 11 R. 10E

Well No. #1 Sherman Mertz Farm
Amerado Company

Wildcat


_____ Ft. from N. Line

330' Ft. from S. Line

_____ Ft. from E. Line

330' Ft. from W. Line

SW NE

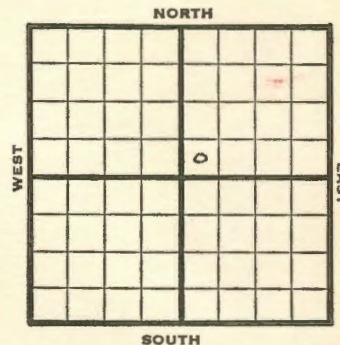

1948

REPORT

7/21 Location

7/28 "

8/4 Spud.

8/11 Drlg 1231'

8/18 TD 1234'
Tight hole**ABANDONED**

Wabunsee County Kansas State
 Map No. 956 Sec. 6 Twp. 11 R. 10E
 Well No. 1 Sherman Mertz


Amerada Company

ABANDONED

Contractor

SW NE

SECTION PLAT

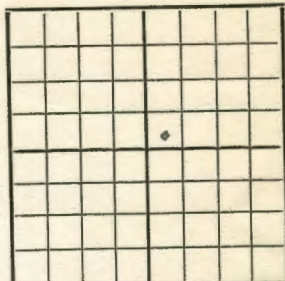

Ft. from N. Line

330 Ft. from S. Line

Ft. from E. Line

330 Ft. from W. Line

Wildcat

Remarks:

TD 1234 tight hole

Date
AUG 18 1948

Scout **S. J. LEWIS**

Wildcat

Map No. _____ Sec. 6 Twp. 11 R. 10E

Well No. 1 Sherman Mertz


Amerado Company

FIRST REPORT

Contractor

SW NE

SECTION PLAT

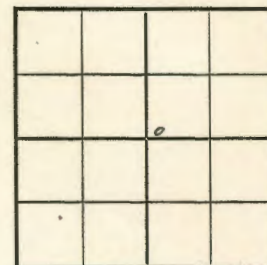

Ft. from N. Line

330 Ft. from S. Line

Ft. from E. Line

330 Ft. from W. Line

Wabunsee County

Location X

Rig up _____

Drilling and Remarks:

RECORD

Cased _____ in., _____ ft.

Sand _____

Gas _____

Oil _____

Total Depth _____

PRODUCTION

1st 24 hrs. Nat. _____

1st 24 hrs. after shot _____

Gas _____ Cu. Ft.

Dry Hole _____

Abandoned _____

Date

JUL 21 1948

19

S. J. LEWIS

Scout