

Sec. 11 Twp. 11 R. 11E

Well No. #1 G. Reiners Farm

Skelly Oil Company

Contractor

Newberry Pool


Ft. from N. Line

990' Ft. from S. Line

330' Ft. from E. Line

Ft. from W. Line

NE SE NW

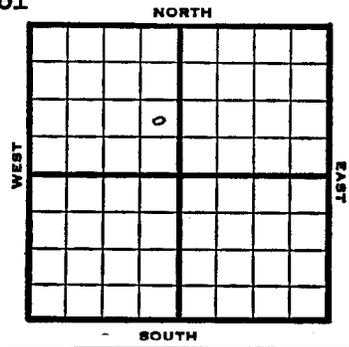


Section 11 Township 11 Range 11E

Well No. #1 G. Reiners

Company Skelly Oil

NORTH

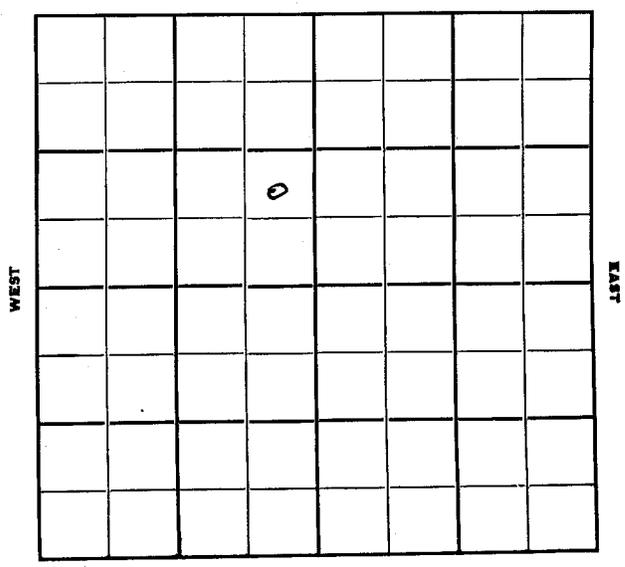

SOUTH


1950	Elev. 1090	REPORT
10/18	Location	
12/27	Spud 10-28-50	
	SWD Well TD 3130	
	8" @ 198	
	Howard 508! Top 573	
	Lans. 940 KC 1272 BKC 1490	
	Miss 2166' Hunton 2545 Viola 2869	
	DST 2869-74 opn 1 hr	
	Rec. 2800' sw Simp. 2931	
	Arb. 3083-3130	
	4 1/2" @ 3086	
	6/2869-78 DST 2869-72 failed	
	TD 3130 Comp. for SWD well	
	Input 1 bfpm	
	ABANDONED	

2991
1090
1991

2981
2545
436

2045
2166
379

County **Waubaunsee** State **Kansas**
 Sec. **11** (Blk. Twp.) **11** (Sur. Rge.) **11E** Map No.
 Operator **Skelly Oil**
 Well No. **1** Farm **G. Reiners**
 Elev. _____ Location **NE SE NW**

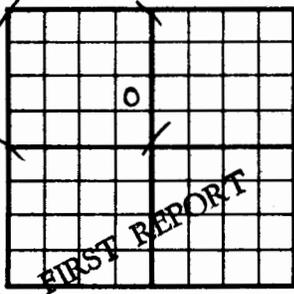


990 Ft. From **S** Line **NW**
330 Ft. From **E** Line **Quarter**
 1st. Report **OCT 18 1950**
 Completion _____
 Remarks _____
 Spudding Date _____

Drig. Data **Newberry Pool**

Location

J. E. TYRA

County **Waubaunsee** State **Kansas**
 Sec. **11** (Blk. Twp.) **11** (Sur. Rge.) **11E** Map No.
 Operator **Skelly Oil**
 Well No. **1** Farm **G. Reiners**
 Elev. **1090** Location **NE SE NW**

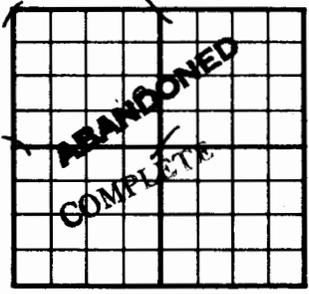

990 Ft. From **S** Line **NW**
330 Ft. From **E** Line **Quarter**
 1st. Report _____
 Completion **DEC 27 1950**
 Remarks **Newberry Pool**
 Spudding Date **10-28-50**

Drig. Data **SWD well TD 3130**

8" C 198 Howard 508 Top. 573
 Lens. 940 KC 1272 B KC 1490
 Miss. 2166 Hunton 2545 Viola 2869
 DST 2869-74 open 1 hr. Rec. 2800' sw
 Si p. 2981 Arb. 3083-3130 **4 1/2" C 3086**
6/ 2869-78 DST 2869-72 failed TD 3130
 Comp. for SWD well Input 1 bfpm

J. E. TYRA