

Sec. 11 Twp. 11 R. 11E

Well No. #2 Fearon Farm

Skelly Oil Company

Atkins - Contr. Contractor

Newberry Pool


990' Ft. from N. Line

Ft. from S. Line

Ft. from E. Line

990' Ft. from W. Line


SE NW NE

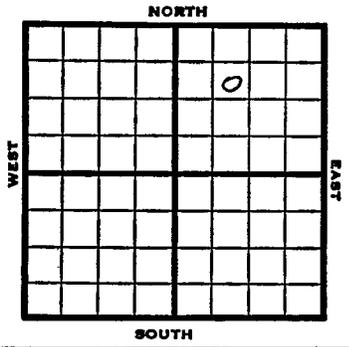

Section 11 Township 11 Range 11 E

Well No. #2 Fearon

Company Skelly Oil

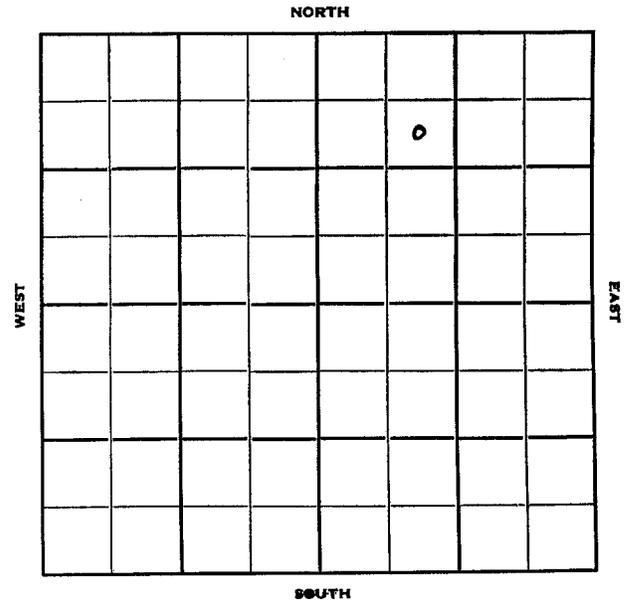

1951 Elev. 1115' REPORT

1/31 Spud 1-27-51
 8" @ 203'
 Drlg. 1058'

3/28 Spud 1-27-51
 Oil well TD 2885'
 8" @ 203 Howard 537' Top. 594'
 Lans. 1163', KC 1298', B KC 1518',
 Miss. 2163', B Miss 2313',
 Hunton 2553', Maq. 2817', Viola
 2882',
 DST 2881-85 open 1½ hr. Rec. 490' oil
 TD 2885', 5" @ 2883, FU 980' fluid
 S/ 55 BO 12 hr. 250 A
 Comp. 380 BOPD

COMPLETED

