

11-11-11E

KANSAS WELL LOG BUREAU -- KANSAS GEOLOGICAL SOCIETY

508 EAST MURDOCK - WICHITA, KANSAS

COMPANY SKELLY OIL CO.

SEC. 11 T. 11 R. 11E

LOC. NE SE NW

FARM ~~Foster~~
G. Reiners

NO. ~~2~~
1

330' fr E.L. 990' fr S.L.

TOTAL DEPTH 3130

COUNTY Wabaunsee
KANSAS


COMM. 10-28-50

COMP. 11-11-50

SHOT OR TREATED

CONTRACTOR Adkins Drlg. Co., Inc.

ISSUED 6-2-51

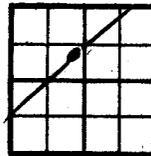

CASING

8 5/8" 198' cem. w/150 sx
4 1/2" 3086' cem. w/590 sx


1092 (2nd.)

ELEVATION 1090 DF

PRODUCTION SWDW

FIGURES INDICATE BOTTOM OF FORMATIONS

shale & lime	207
shale & shells	630
shale & lime	1270
lime	1485
shale	1530
lime & shale	1760
lime, shale & sand	2155
lime & chert	2300
shale	2544
lime & chert	2640
lime	2800
shale	2869
lime	2975
shale & sand	3011
sand	3083
lime	3130
Total Depth	

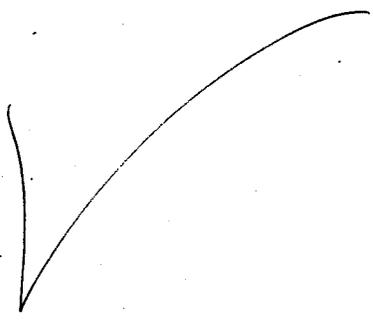

Tops:	
Howard	506
Topeka	572
Lansing	1136
Kansas City	1272
Miss. Lime	2166
Kinderhook	2300
Hunton	2544
Maquoketa	2800
Viola	2869

Salt Water disposal formation
3086-3130'

Porosity with some free oil -
2872-74'

Attempted to take D.S.T. #1 -
2871'-2874'; packer failed to
hold

Ran Schlumberger Survey to 2874'.

DST: #2 - 2869'-2874'; tool
open 1 hr; rec. 2850' of salt
water, no oil (last 420'

slightly cut with gas.) B.H.P.
after 15 min. shut in 1250#.

Attempted DST: #3 - 2869'-2872';
packer failed to hold.

A second effort was made to DST:
this same upper portion of the
Viola Lime; Packer again failed
to hold.