

This form shall be filed in triplicate with the Kansas Corporation Commission, 200 Colorado Derby Building, Wichita, Kansas 67202, within ten days after the completion of the well, regardless of how the well was completed. Circle one: Oil, gas, dry, SWD, OWWO, injection. Type and complete ALL sections. Applications must be filed for dual completion, commingling, salt water disposal and injection. Attach wireline logs (i.e. electrical log, sonic log, gamma ray neutron log, etc.) KCC#-(316)263-3238.

OPERATOR TGT PETROLEUM CORP.

API NO. \_\_\_\_\_

ADDRESS 209 East William

COUNTY Wabaunsee

Wichita, Ks. 67202

FIELD \_\_\_\_\_

\*\*CONTACT PERSON B. Lynn Herrington

PROD. FORMATION \_\_\_\_\_

PHONE 316-262-6489

LEASE Hurla

PURCHASER \_\_\_\_\_

WELL NO. 3

ADDRESS \_\_\_\_\_

WELL LOCATION \_\_\_\_\_

DRILLING TGT PETROLEUM CORP.

630 Ft. from N Line and

CONTRACTOR \_\_\_\_\_

980 Ft. from W Line of

ADDRESS 209 East William

the NW SEC. 23 TWP. 11S RGE. 11E

Wichita, Ks. 67202

PLUGGING TGT PETROLEUM CORP.

CONTRACTOR \_\_\_\_\_


ADDRESS 209 East William

Wichita, Ks. 67202

TOTAL DEPTH 540' PBDT \_\_\_\_\_

SPUD DATE 10/22/81 DATE COMPLETED 10/28/81

ELEV: GR 1002 DF \_\_\_\_\_ KB \_\_\_\_\_

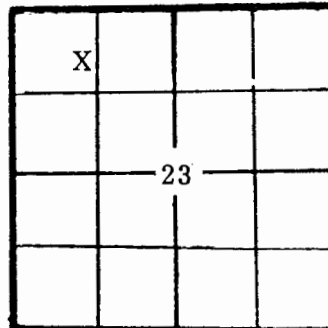

WELL PLAT

KCC \_\_\_\_\_  
KGS   
MISC \_\_\_\_\_  
(Office Use)

DRILLED WITH (CABLE) (ROTARY) (AIR) TOOLS (New) / (Used) casing. None

CASING RECORD

Report of all strings set — surface, intermediate, production, etc.

Purpose of string	Size hole drilled	Size casing set (in O.D.)	Weight lbs/ft.	Setting depth	Type cement	Sacks	Type and percent additives

LINER RECORD

PERFORATION RECORD

Top, ft.	Bottom, ft.	Sacks cement	Shots per ft.	Size & type	Depth interval

Size	Setting depth	Packer set at

ACID, FRACTURE, SHOT, CEMENT SQUEEZE RECORD

Amount and kind of material used	Depth interval treated

23-11-11E

23-11-11E

Estimated height of cement behind Surface Pipe 40' to top.

DV USED? \_\_\_\_\_

WELL LOG

Formation Description, Contents, etc.	Top	Bottom	Name	Depth
Clay, sandy clay & sand	0	30		
Shale & lime	30	540		

A F F I D A V I T

STATE OF Kansas, COUNTY OF Sedgwick SS, \_\_\_\_\_

B. Lynn Herrington OF LAWFUL AGE, BEING FIRST DULY SWORN UPON HIS OATH,

DEPOSES THAT HE IS Executive Vice President (FOR)(OF) TGT Petroleum Corp.

OPERATOR OF THE Hurla LEASE, AND IS DULY AUTHORIZED TO MAKE

THIS AFFIDAVIT FOR AND ON THE BEHALF OF SAID OPERATOR, THAT WELL NO. \_\_\_\_\_ ON

SAID LEASE HAS BEEN COMPLETED AS OF THE \_\_\_\_\_ DAY OF \_\_\_\_\_, 19\_\_\_\_, AND THAT