


Section 2 Township 11 Range 11E

Well No. #2 M. C. Wagner

Company Skelly Oil

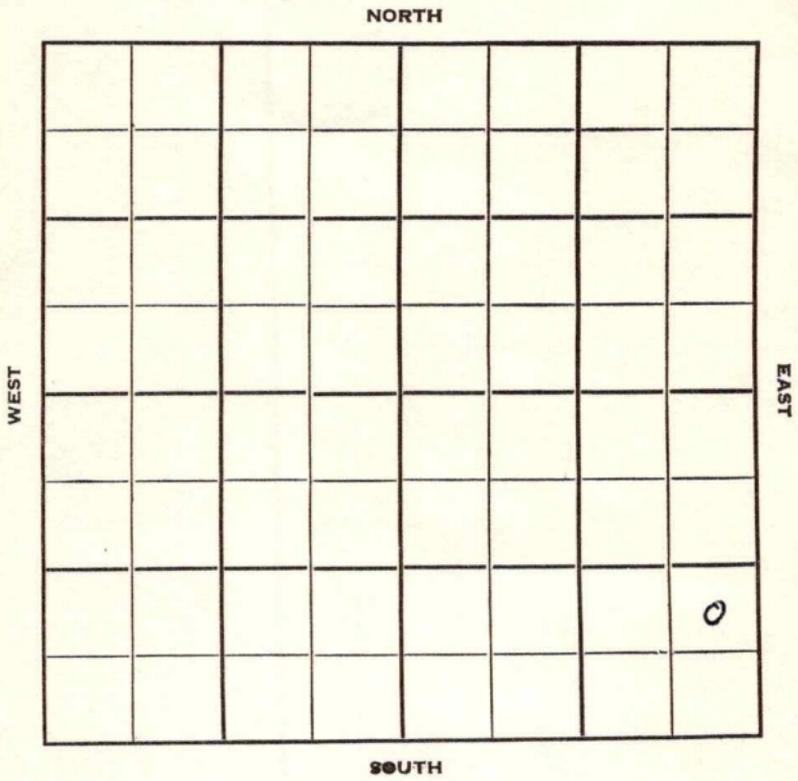

Waubaunsee

**KANSAS**

Sec. 2 Twp. 11 R. 11E

Well No. #2 M. C. Wagner Farm

Skelly Oil Company

Adkins Contractor

Newburry Pool

Ft. from N. Line

NORTH


990' Ft. from S. Line

330' Ft. from E. Line

WEST

EAST

Ft. from W. Line

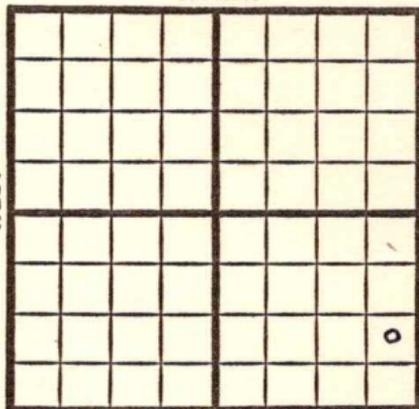

SOUTH

NE SE SE

1951

**Elev. 1114'**

REPORT

6/6

Spud 6-2-51  
10" @ 204'  
WOC

8/15

Spud 6-2-51  
Oil well TD 2889' 10" @ 204'  
**Viola 2884'**  
DST 2881-89 open 1½ hr. rec 135' oil  
15' OCM 7" @ 2884' TD 2889'  
FU 1000'  
Comp. 77 BOPD

**COMPLETED**



