

KANSAS

Map No. _____ Sec. *2* Twp. *11* R. *11*

Well No. *1 Paul* Farm _____


Ramsey Pit Company _____

1120' Ft. from N. Line

_____ Ft. from S. Line

200' Ft. from E. Line

_____ Ft. from W. Line

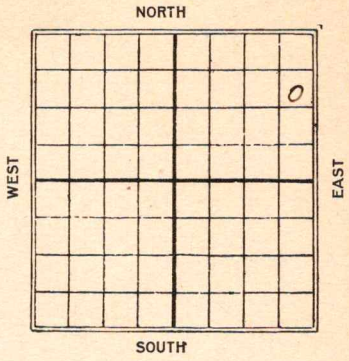

1925

Date	REPORT
<i>9/23</i>	<i>Timbers</i>
<i>10/1</i>	<i>Rigging up</i>
<i>10/8</i>	_____
<i>10/16</i>	_____
<i>10/22</i>	<i>15° @ 125</i>
<i>10/29</i>	_____
<i>11/6</i>	_____
<i>11/13</i>	_____
<i>11-19</i>	<i>5/0 125</i>
<i>11-27</i>	_____
<i>12/3</i>	_____
<i>12/10</i>	_____
<i>12/17</i>	<i>Only 1155'</i>
<i>12/23</i>	_____
<i>12/31</i>	_____
<i>1926</i>	_____
<i>1/8</i>	_____
<i>1/14</i>	<i>Only 1625' casing</i>
<i>1/20</i>	_____
<i>1/27</i>	_____

2/4 - _____

2/10 - Dlg 2415'

2/17 H.F.W 2613' - 210.2614

S.R. 6"

2/23 - _____

3/5 - S.D. 2800'

3/11 - Abandoned 2815'

Habunsee County,

Wagon KANSAS Map No. _____ Sec. *2* Twp. *11* R. *11*

Well No. *1 Skane* _____

Ramsay Pet. Co. _____ Company

_____ Contractor

COMPLETED

SECTION PLAT

1120 Ft. from N. Line

_____ Ft. from S. Line

200 Ft. from E. Line

_____ Ft. from W. Line

				o

ABANDONED

Location _____

Rig up _____

Drilling and Remarks:

N 7 A 2615'
Sup Lime 2700'
Dry + Aband 20
2815'

RECORD

Cased _____ in., _____ ft.

Sand _____

Gas _____

Oil _____

Total Depth *2815*

PRODUCTION

1st 24 hrs. Nat. _____

1st 24 hrs. after shot. _____

Gas _____ Cu. Ft.

Dry Hole _____

Abandoned _____

Date

MAR 11 1926

CHAS. L. SHERWOOD

192

Scout

Wabunsee Co

Map No. **KANSAS** Sec. *2* Twp. *11* R. *11*

Well No. *1* *Hub*

Sumley Pet Co Company

Contractor

FIRST REPORTS

SECTION PLAT

1120 Ft. from N. Line

Ft. from S. Line

200 Ft. from E. Line

Ft. from W. Line

Location _____

Rig up *Sumbers*

Drilling and Remarks:

RECORD

Cased _____ in., _____ ft.

Sand _____

Gas _____

Oil _____

Total Depth _____

PRODUCTION

1st 24 hrs. Nat. _____

1st 24 hrs. after shot _____

Gas _____ Cu. Ft.

Dry Hole _____

Abandoned _____

Date

SEP 25 1925

192 **CHAS. L. SHERWOOD** Scout