


22
S
11

Leavenworth
County
Rutherford No. 2
Farm
S. R. McKinney
Company

11
Section

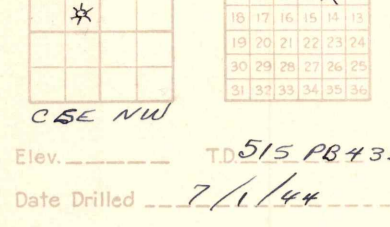

Elev. _____ TD 515 PB 435
 Date Drilled 7/1/44
 Correlation by _____
 50,000 G.

