


Section 11 Township 11 Range 11 E

Well No. # 4 Ferron

Company Skelly Oil

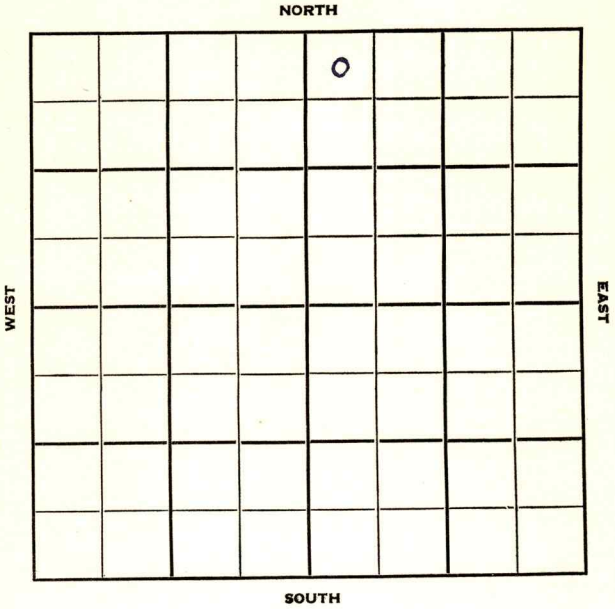

Sec. 11 Twp. 11 R. 11 E ✓

Well No. # 4 Ferron Farm

Skelly Oil Company

Contractor

Newbury Pool


330 Ft. from N. Line

Ft. from S. Line

Ft. from E. Line

330 Ft. from W. Line

NW NW NE

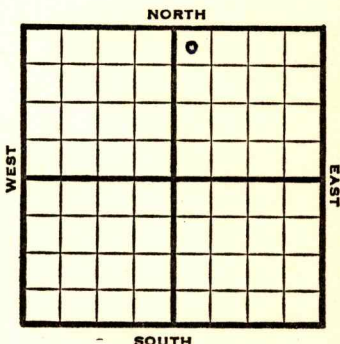

1951

Elev. 1132'

REPORT

2/28

Location

5/23

Spud 2-28-51 *2910'*
 Oil well TD *3910'* 8" @ 198
Howard 553' Top 617' Lans 1181'
KC 1316' B KC 1531' Miss 2170'
Hunton 2583' Viola 2904'
 DST 2904-09 open 1 hr. rec 1500' oil
 5" @ 2904 FU 2900' fluid 500' oil
 S/68 BO 18 BW 2 hr. DD 2910' water
 PB 2906' 150 A S/75 BO 5 hr.
 P/43 BO & water 7 hr.
 P/15 BO 16 BW 3 hrs.
 Comp. 360 BOPD 80% water

COMPLETED

County Waubaussee State Kansas

Sec. 11 (Blk. 11) (Sur. 11E) (Twp.) 11 Map No.

Operator Skelly Oil

Well No. 4 Farm Ferron

Elev. 11320 Location NW NW NE



330 Ft. From N Line NE

330 Ft. From W Line Quarter

1st. Report

Completion MAY 23 1951

Remarks Newbury Pool

Spudding Date 2-28-51

Drlg. Data Oil well TD 3910 2910

8" @ 198 Howard 553 Top. 617

Lans. 1181 KC 1316 B KC 1531

Miss. 2170 Hunton 2583 Viola 2904

DST 2904-09 open 1 hr. Rec. 1500' oil

5" @ 2904 FU 2900' fluid 500' oil

S/ 68 bo 18 bw 2hr. DD 2910 water

PB 2906 150A S/ 75 bo 5 hr.

P/ 43 bo & water 7 hr. P/ 15 bo 16 bw 3hr

Comp. 360 bopd 80% water

J. E. TYRA