


Section 11 Township 11 Range 11E

Well No. #6 Fearon

Company Skelly O, I

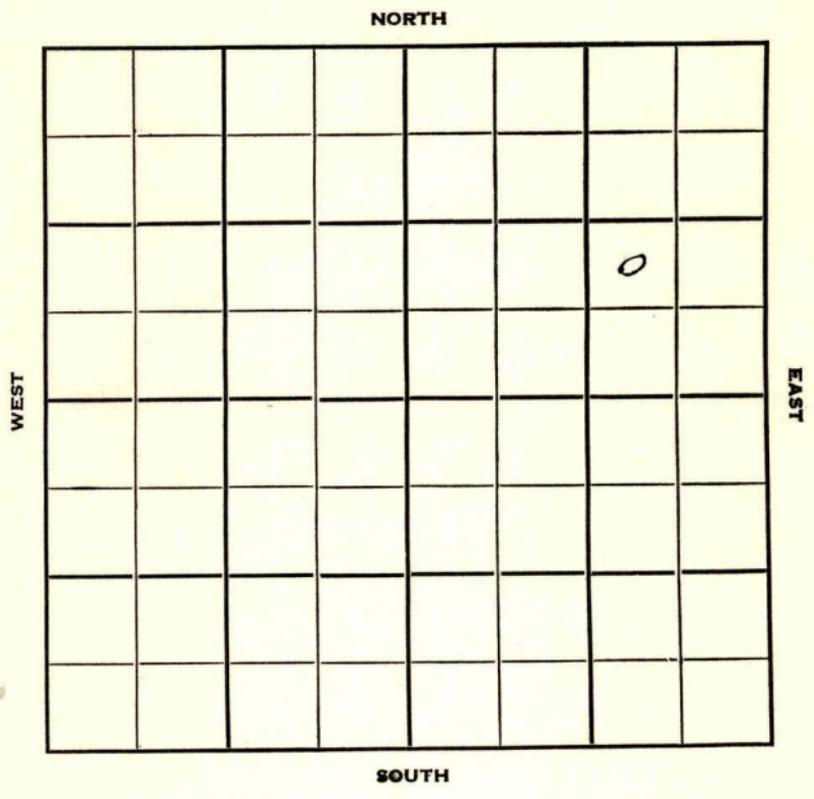

Sec. 11 Twp. 11 R. 11 E ✓

Well No. # 6 Fearon Farm

Skelly Oil Company

Contractor

**Newberry Pool**

Ft. from N. Line


NORTH

990 Ft. from S. Line

990 Ft. from E. Line

Ft. from W. Line

NW SE NE

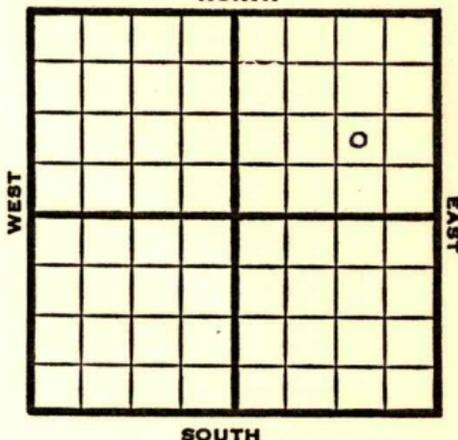

1951

**Elev. - REPORT**

4/11

Location

6/20

Spud 4-11-51  
Oil Well TD 2885  
8" @ 211

Howard 520	Top 592
Lans. 1161	KC 1296
BKC 1507	Miss 2157
Kh 2318	Hunton 2555
Viola 2881	TD 2883

DST 2874-83 opn 15 min.

Rec. 4' ocm 1 go

DST 2879-83 opn 1/2 hr Rec. 15' ocm  
1 go DD 2885

DST 2878-85 opn 1 1/2 hr. Rec. 710' oil  
10' mud 5" @ 2882 15/2875-80

15/2865-70 S/17 bo 1 1/2 bw 3 1/2 hr.

P/26 bo 6 bw 6 hr

Comp. 125 bopd 50% wtr.

**COMPLETED**



