


Section 11 Township 11 Range 11E

Well No. #5 Fearon

Company Skelly Oil

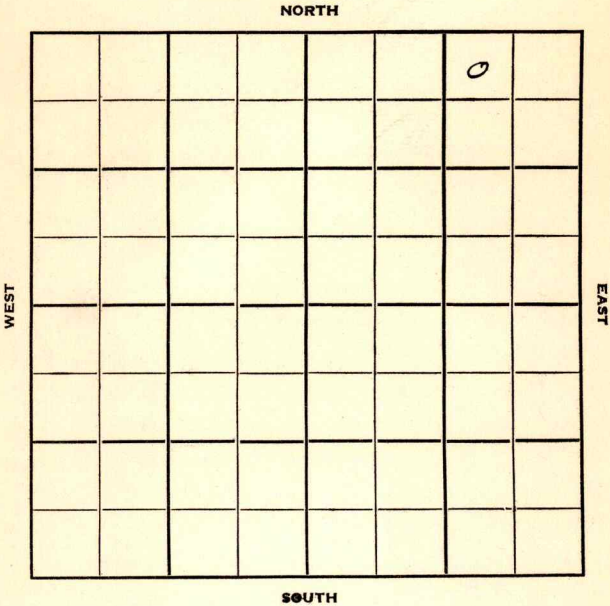

Sec. 11 Twp. 11 R. 11 E

Well No. # 5 Fearon Farm

Skelly Oil Company

Atkins Contractor


330 Ft. from N. Line

 Ft. from S. Line

990 Ft. from E. Line

 Ft. from W. Line

NW NE NE

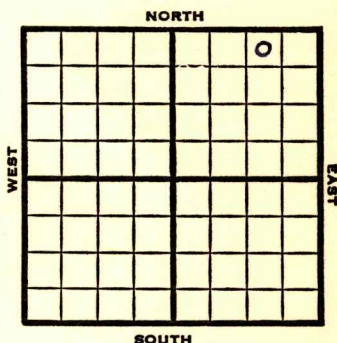

1951

Elev. 1106'

REPORT

3/21

R U R

5/23

Spud 3-20-51

Oil well TD 2877' 8" @ 216'

Hunton 2528'

DST 2529-34' open 1 hr. rec 10' OCM

DST 2531-53 open 1 hr. rec 900' water

SSO

Maq. 2798' Viola 2873'

DST 2873-77 open 1½ hr. rec 400' clean oil. TD 2877' 5" @ 2873'

S/68 BO 16 hr.

P/14 BO 2 hr.

P/41 BO 8 hr. 250 A

P/15 BO 3 hr.

Comp. 677 BOPD 2% water

COMPLETED



11

Skelly Oil

5

Location

O

330 Ft. From

990 Ft. From

MAR 21 1951

Completion

Remarks

Atkins - Contr.


Spudding Date

Drlg. Data

R U R

J. E. TYRA

County Waubaussee State Kansas
 Sec. 11 (Blk. 11 (Sur. 11E Map No.
 (Twp.) (Rge.)
 Operator Skelly Oil
 Well No. 5 Farm Ferron
 Elev. 1106 Location NW NE NE

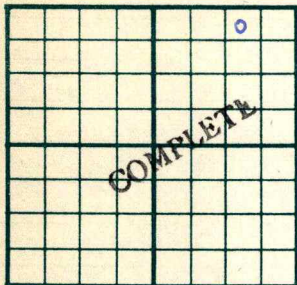

330 Ft. From N Line NE
990 Ft. From E Line Quarter
 1st. Report
 Completion MAY 23 1951
 Remarks
Atkins - Contr.
 Spudding Date 3-20-51

Drig. Data Oil well TD 2877
8" @ 216 Hunton 2528 DST 2529-34
open 1 hr. Rec. 10' ocm DST 2531-53
open 1 hr. Rec. 900' water SSO
Maq. 2798 Viola 2873 DST 2873-77
open 1½ hr. Rec. 400' clean oil TD 2877
5" @ 2873 S/ 68 bo 16 hr. P/ 14 bo 2 hr
E/ 41 bo 8 hr. 250 A P/ 15 bo 3 hr.
Comp. 677 bopd 2% water

J. E. TYRA