


Section 11 Township 11 Range 11 E

Well No. # 7 Fearon

Company Skelly Oil

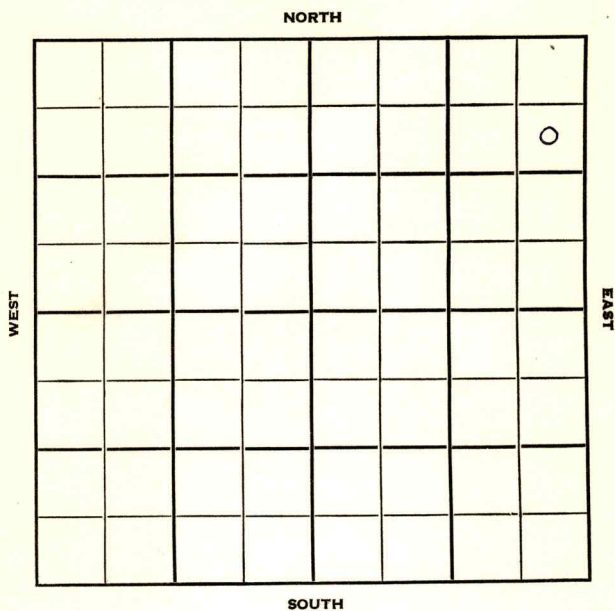

Waubaussee

KANSAS



Sec. 11 Twp. 11 R. 11 E

Well No. # 7 Fearon Farm

Skelly Oil Company

Contractor

Newberry Pool


990 Ft. from N. Line

 Ft. from S. Line

330 Ft. from E. Line

 Ft. from W. Line

SE NE NE

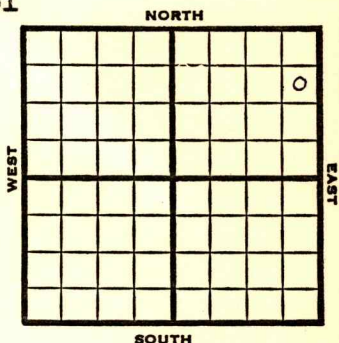

1951

Elev. -

REPORT

5/2

6/5

Location

Spud 5-4-51

D&A TD 2880

8" @203

Miss 2162' Kinderhook 2306

Hunton 2548 Viola 2877

TD 2880

DST 2876-80 opn 1½ hr Rec. 100' oil

30' ocm 5" @ 2877 S/3 bo 3 hr

D&A

ABANDONED

County Waubaussee State KansasSec. 11 (Blk. 11) (Sur. 11E) Map No.Operator Skelly OilWell No. 7 Farm FearonElev. Location SE NE NE

FIRST REPORT

990 Ft. From N Line NE330 Ft. From E Line Quarter1st. Report MAY 2 1951

Completion

Remarks

Spudding Date

Drlg. Data

Newberry Pool

Location

J. E. TYRA

(Blk.)
(Twp.)

Skelly Oil

7

Location

ABANDONEL

N

५

1st. Report

JUN 6 1951

Newberry Pool

5-4-51

D & A

8" @ 203 Miss. 2162 Kinderhook 2306

Viola 2877 TD 2880

DST 2876-80 open $1\frac{1}{2}$ hr. Rec. 100' oil

30' ocm 5" @ 2877 S/ 3 bo 3 hr.

D & A

J. E. TYRA