

KANSAS


Wabaunsee

Section 8 Township 11 Range 12E

Well No. 1 Uhlrig

Company Helmerich & Payne

Wildcat

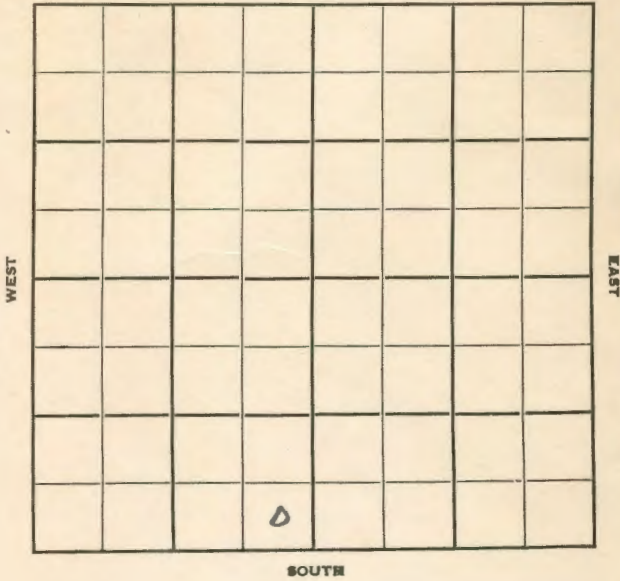

Wabaunsee **KANSAS**

Sec. 8 Twp. 11 R. 12E

Well No. #1 Uhlrig Farm

Helmerich & Payne Company

Wildcat

_____ Ft. from N. Line

330'


_____ Ft. from S. Line

330'

_____ Ft. from E. Line

_____ Ft. from W. Line

SE SW

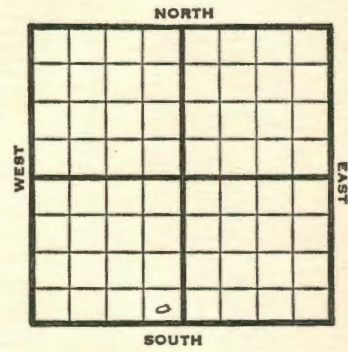

1949 Elev. 1020' REPORT

9/21
9/30
10/5

Location → 8" @ 218'

Miss 2264' **Kansing 1605'**

Hunton 2605' **KC 1255'**

Viola 2957' **BKC 1465'** ✓

Simpson 3068' **Drlg 2308'**

Arb. 3174'

TD 3227'

Abd.

ABANDONED

$\frac{2605}{2264} = 341$

$\frac{3068}{2605} = 463$

$\frac{3068}{1620} = 2048$

~~Lens - 585~~
BKC - 445
BKC-M 799

$\frac{1605}{1020} = 585$

$\frac{1465}{1020} = 445$

$\frac{2264}{1465} = 799$

Map No. _____ Sec. 8 Twp. 11 R. 12E

Well No. 1 Uhlrig

Helmerich & Payne Company

ABANDONED Contractor

SE SW

E1.1020
SECTION PLAT

_____ Ft. from N. Line

330 Ft. from S. Line

330 Ft. from E. Line

_____ Ft. from W. Line

Wabaunsee County

Location _____

Rig up _____

Drilling and Remarks:

*Mine 2264
Hunt ton 2605
Vid. ton 2957
Sing 3068
Est 3174*

RECORD

Cased _____ in., _____ ft.

Sand _____

Gas _____

Oil _____

Total Depth *3227*

PRODUCTION

1st 24 hrs. Nat. _____

1st 24 hrs. after shot _____

Gas _____ Cu. Ft.

Dry Hole _____

Abandoned _____

Date

OCT 5 1949 19 S. J. LEWIS Scout

Map No. _____ Sec. 8 Twp. 11 R. 12E

Well No. 1 Uhlrig

Helmerich & Payne Company

Contractor

SE SW

FIRST REPORT
SECTION PLAT

_____ Ft. from N. Line

330 Ft. from S. Line

330 Ft. from E. Line

_____ Ft. from W. Line

Wabaunsee County

Location *X* _____

Rig up _____

Drilling and Remarks:

RECORD

Cased _____ in., _____ ft.

Sand _____

Gas _____

Oil _____

Total Depth _____

PRODUCTION

1st 24 hrs. Nat. _____

1st 24 hrs. after shot _____

Gas _____ Cu. Ft.

Dry Hole _____

Abandoned _____

Date

SEP 21 1949 19 S. J. LEWIS Scout