

KANSAS

FORM 51 5M 10-41 PETROL


Leavenworth

Section 13 Township 11 Range 21E

Well No. #1 Bracy


Company Heuisman 854

Miscellaneous NORTH

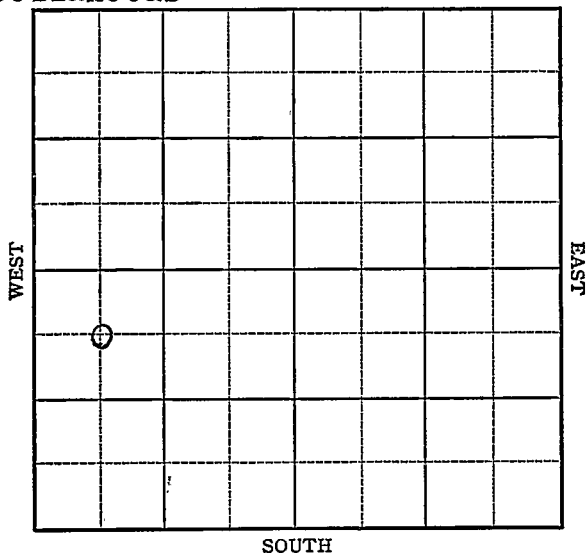

Sec. 13 Twp. 11 R. 21EWell No. 1-Bracy FarmHeuisman Company

(Miscellaneous)

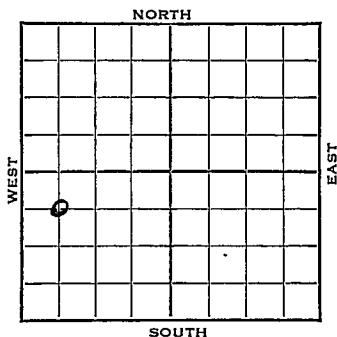660 Ft. from N. Line Ft. from S. Line Ft. from E. Line660 Ft. from W. Line

1942

REPORT

9/30

8" 180

Dlgs. 625

10/7

Drlgs. 1000'

10/14

1116 SD

10/21

" "

10/28

Miss. 1115' water
T.D. 1116'

ABANDONED

Leavenworth

Map No. MM Sec. 13 Twp. 11 R. 21E

Well No. 1 Bracy

Heuisman _____ Company

Contractor

C N W S W

SECTION PLAT

660 Ft. from N. Line

Ft. from S. Line

Ft. from E. Line

660 Ft. from W. Line

0			

MISCELLANEOUS

Location_____

Rig up_____

Drilling and Remarks:

Only 625

RECORD

Cased 8" in., 180 ft.

Sand _____

Gas

Oil 100.00Total Depth

PRODUCTION

1st 24 hrs. Nat. _____

1st 24 hrs. after shot_____

Gas _____ Cu. Ft.

Drv Hole _____

Abandoned

Date FIRST REPORTS

SEP 30 1942 19

S. J. LEWIS Scout

Map No. N M Sec. 13 Twp. 11 R. 21EWell No. 1 Bracy

Heuismen

Company

ABANDONED

Contractor

C NW SW

SECTION PLAT

660 Ft. from N. Line Ft. from S. Line Ft. from E. Line660 Ft. from W. Line

MISCELLANEOUS

Location Rig up

Drilling and Remarks:

*Miss 1115**Water*

RECORD

Cased in., ft.Sand Gas Oil Total Depth 1116

PRODUCTION

1st 24 hrs. Nat. 1st 24 hrs. after shot Gas Cu. Ft.Dry Hole Abandoned

Date

OCT 2 8 1942 19S. J. LEWIS Scout