

County: Shawnee Fraction _____ Sec. 16 T 11 S R 15 W

CORRECTION(S) TO

COMPLETION RECORD (WWC-5)

(To rectify lacking or incorrect information)

Owner: KDOT

Location was listed as:

~~Section-Township-Range: _____~~

~~Fraction (1/4 1/4 1/4): _____~~

Changed to:


Other changes: Initial statements: Station # 143 + 98.5, 64' RT & US-24

Changed to: _____

Comments: KDOT core available for CD 2 also
(no paperwork as of 12/10/2015)

Verification method: _____

Submitted by: _____ initials: CN date: 12/10/2015
to: Kansas Geological Survey, Data Resources Library, 1930 Constant Ave., Lawrence, KS 66047-3726
to: Kansas Dept of Health & Environment, Bureau of Water, 1000 SW Jackson, Suite 420, Topeka, KS 66612-1367.

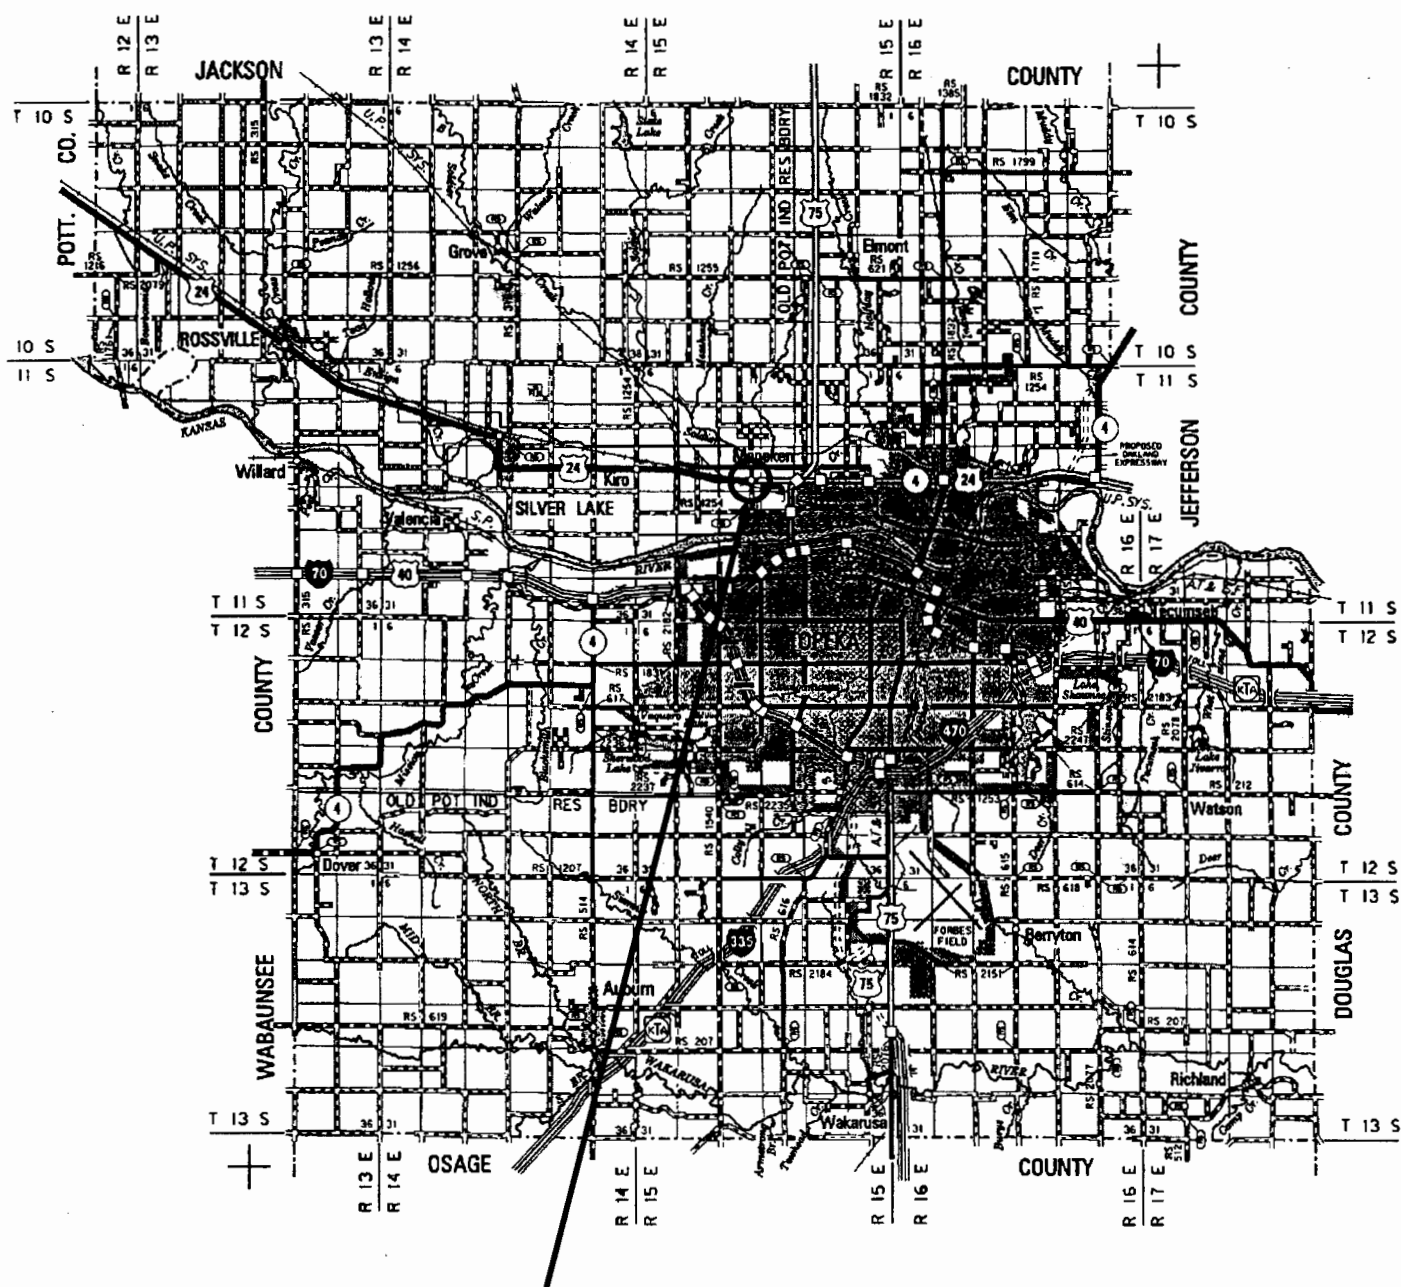

24-89 K-7431-01

EB & WB US-24 over Menoken Road

Bridge Nos. 24-89-17.67(296)WB

Shawnee County

CD 03

N:39.091597 E-95.748754 (Approx.)

SE ¼, NW ¼, SE ¼, Section 16, T11S, R15E