


Geary

15-061-00034

Form 51-5M-4-27-27423

Map No. **KANSAS** Sec. **17** Twp. **11** R. **5E**Well No. **1-Younger** Farm
Wright et al Company

NORTH

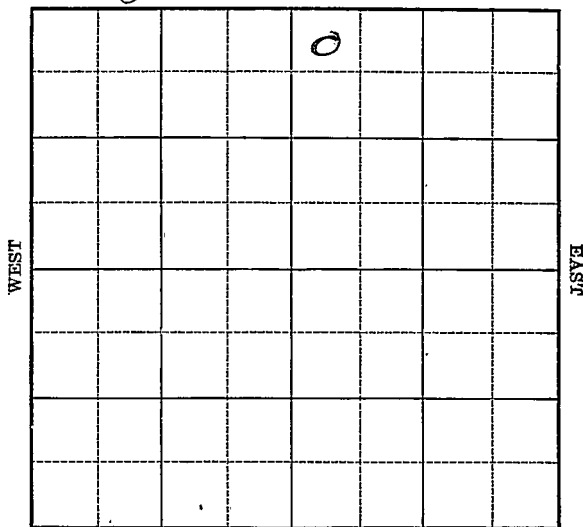

SOUTH

L & S 1222

Location _____

Drilling Remarks _____

Rig Up _____

Drilling Remarks _____

RECORD

Cased _____ in. _____ ft.

Sand _____

Gas _____

Oil _____

Total Depth _____

PRODUCTION

1st 24 hrs. Nat. _____

1st 24 hrs. after shot _____

Gas _____ cu. ft.


Dry Hole _____

Abandoned _____

KANSAS

Map No. _____ Sec. 17 Twp. 11 R. 5Well No. 1-Youngken Farm
Wright et al Company

NORTH

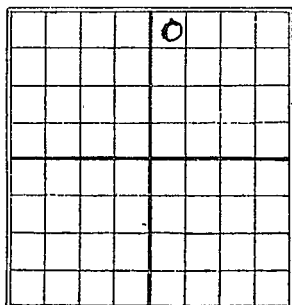330 Ft. from N. Line

_____ Ft. from S. Line

_____ Ft. from E. Line

330 Ft. from W. Line

SOUTH

1928

Date

REPORT

7/13	Bldg.
7/19	Rigging up-
7/26	S.D. 650
8/2	—
8/9	—
8/16	—
8/23	—
8/28	—
9/4	—
9/12	—
9/19	—
9/26	—
10/3	—
10/10	—
10/17	—
10/24	—
10/31	—
11/7	—
11/14	—
11/21	—
11/28	8" at 1825"
	Drily at 1830'

12/5 - 8" - 1825 - Only 18

12/12 —————

12/19 —————

12/26 - S.D. 1830'

1929

1/2 —————

1/9 —————

1/16 —————

1/23 —————

1/30 —————

2/6 —————

2/13 —————

2/20 —————

2/27 —————

3/6 - S.D. 2150'

3/13 —————

3/20 —————

3/27 —————

4/3 —————

4/10 —————

4/17 —————

4/24 —————

5/1 —————

5/8 —————

5/15 —————

5/22 - fsg 6" - 2170'

5/29 —————

6/5 —————

6/12 —————

6/19 - S.D. 2250'

6/26 ————— 7/31 —————

7/2 ————— 8/7 —————

7/10 ————— 8/14 - fsg 2250'

7/17 ————— 8/21 ————— 9/4 —————

7/24 ————— 8/28 ————— 9/11 —————

Map No. *etc* Sec. *17* Twp. *11* R. *5*Well No. *1-Young Run* Farm*Wright et al* Company

NORTH

WEST

EAST

SOUTH

330 Ft. from N. Line

Ft. from S. Line

Ft. from E. Line

330 Ft. from W. Line*1929*

Date

REPORT

*9/17 log 2250' TD.**9/25**10/2**10/9**Chat 2015-70'
show at 2270'
HFW at 2303
dry 2360'**10/16**10/23**10/30**11/6**11/13**11/20**11/27**12/4**12/11**12/23**12/30**1930**1/7**1/15**Fog tools 3240'**1/22 — 3/5 —**1/29 — 3/2 —**2/4 — 3/19 —**2/11 — 3/26 —**2/19 — 4/2 —**2/26 — 4/9 —*

4/16 - Isq. tools 3240

4/23 —

4/30 —

5/7 —

5/14 —

5/21 —

5/28 —

6/4 —

6/11 —

6/18 —

6/25 —

7/2 —

7/9 —

7/16 —

7/23 —

7/30 —

8/6 —

8/13 —

8/20 —

8/27 —

9/3 —

9/10 —

9/17 —

9/24 - T.D. 3240

Dry & Abandon

KANSAS

Glory

Map No. _____ Sec. 17 Twp. 11 R. 5

101

Well No. 1 YounkenWright Co _____ Company

Contractor

COMPLETE

SECTION PLAT

330

Ft. from N. Line

Ft. from S. Line

Ft. from E. Line

330

Ft. from W. Line

ABANDONED

		0	

Location _____

Rig up _____

Drilling and Remarks:

RECORD

Cased _____ in., _____ ft.

Sand _____

Gas _____

Oil _____

Total Depth 3240

PRODUCTION

1st 24 hrs. Nat. _____

1st 24 hrs. after shot _____

Gas _____ Cu. Ft.

Dry Hole ☒Abandoned ☒

Date

SEP 2 1 1930

CHAS. L. SHERWOOD

19

Scout

was
small map

Returned	
Cards	
Tracing	<i>OK</i>
France Map	<i>i</i>
Scarborough Map	X
Moody Map	X
Scarborough Plat Book	
Moody Plat Book	

SEP 3 1 1930
J. J. WHITE

MAP No. 330 SEC. 17 TWP. 11 R. 5 ^E

WELL No. 1 Yountken
Wright et al COMPANY

CONTRACTOR

FIRST REPORTS

330 FT. FROM N. LINE

FT. FROM S. LINE

FT. FROM E. LINE

330 FT. FROM W. LINE

SECTION PLAT

		0	

LOCATION

RIG UP

DRILLING AND REMARKS:

Blow

RECORD

CASED IN. FT.

SAND

GAS

OIL

TOTAL DEPTH

PRODUCTION

1ST 24 HRS. NAT.

1ST 24 HRS. AFTER SHOT

GAS CU. FT.

DRY HOLE

ABANDONED

DATE

7/13/28 192 Sherwood SCOUT

no wall map
no Small map

Returned	
Cards	
Tracing	
France Map	
Scarborough Map	
Moody Map	
Scarborough Plat Book	
Moody Plat Book	