

15-041-00131


KANSAS
FORM 5, 1951 PETROL

Dickinson

Section 17 Township 11 Range 1E

Well No. #1 Mustard

Company Wolf Creek etal

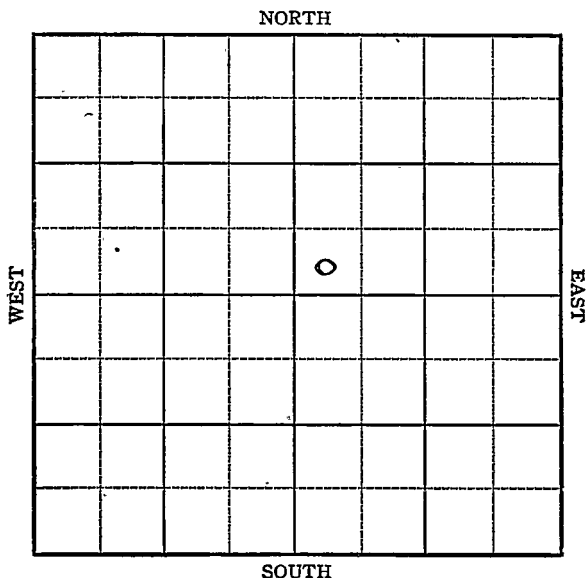

KANSAS

Sec. 17 Twp. 11 R. 1E

Well No. #1 Mustard Farm
Wolf Creek etal. Company

Wildcat

 Ft. from N. Line


330 Ft. from S. Line

 Ft. from E. Line

330 Ft. from W. Line

SW NE

Sec. 1334

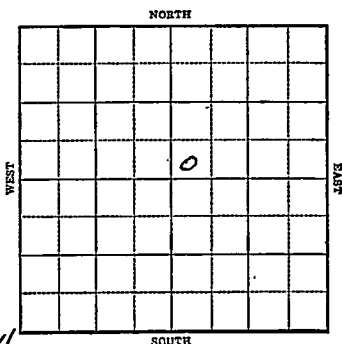

1944

R E P O R T

2/9 Cellar
2/15 Rotary
2/23 10" @ 101
WOC.
3/1 Drlg. 2185'
3/7 Miss 2490
Hunton 2860
Viola 3152
Drlg. 3296
3/15 Arb. 3369
TD 3411

*2860
2490

370*

ABANDONED

2866

KANSAS

Map No. 50 Sec. 17 Twp. 11 R. 1EWell No. 1 MustardWolf Creek et al. CompanyABANDONED Contractor

SW NE

SECTION PLAT

		o	

 Ft. from N. Line330 Ft. from S. Line Ft. from E. Line330 Ft. from W. Line

Wildcat

Location Rig up

Drilling and Remarks:

Per 8 3369

RECORD

Cased in., ft.Sand Gas Oil Total Depth 3411

PRODUCTION

1st 24 hrs. Nat. 1st 24 hrs. after shot Gas Cu. Ft.Dry Hole Abandoned

Date

MAR 15 1944 19

S. J. LEWIS

Scout

KANSAS


Map No. 50 Sec. 17 Twp. 11 R. 1EWell No. 1 MustardWolf Creek et al. Company

FIRST REPORT

Contractor

SW NE

SECTION PLAT

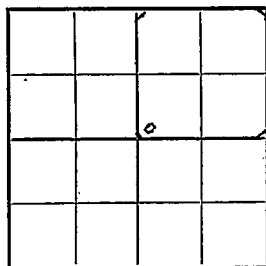

Ft. from N. Line

330

Ft. from S. Line

Ft. from E. Line

330

Ft. from W. Line

Wildcat

Location

Rig up

Drilling and Remarks:

Cellar

RECORD

Cased _____ in., _____ ft.

Sand _____

Gas _____

Oil _____

Total Depth _____

PRODUCTION

1st 24 hrs. Nat. _____

1st 24 hrs. after shot _____

Gas _____ Cu. Ft.

Dry Hole _____

Abandoned _____

Date

FEB 9 1944 19

S. J. LEWIS

Scout