

15-161-00026

Riley

KANSAS

SECTION 19 TOWNSHIP 11S RANGE 8E


WELL NO. #1 F. R. McDermind

COMPANY Pure Oil

NORTH

WEST

EAST

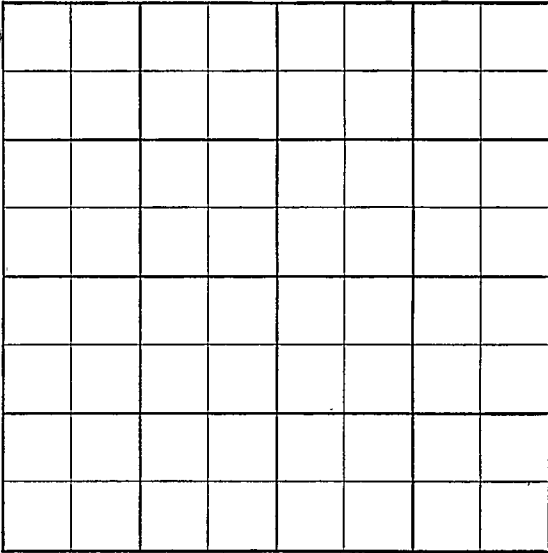

SOUTH

M

~~Top~~ X ~~Foot~~

No ~~Foot~~

# WILDCAT

5-513-B

County Riley Elev. \_\_\_\_\_

Sec. 19 Twp. 11 Rge. 8E

Company Pure Oil

Farm Name F. R. McDermind No. 1

TOPS	DEPTH	LOG	DATUM
Anh.			
✓ Tp.			
✓ H.			
✓ Tr.			
✓ Dg.			
✓ B.L.			
✓ L.			
K.C.			
B.K.C.			
Ce.			
C.			
M.			
M.			
K.			
Mz.			
Mq.			
V.			
S.			
S.			
A.			
R.			
Pf.			
G.			
T.D.			

Loc. in Sec. 1488' WL

1650' SL

Geol. \_\_\_\_\_  
Contr. \_\_\_\_\_  
Shira Drlg

Pool Wildcat

**FIRST REPORT**

Date Comm. M I R

Co. \_\_\_\_\_  
Lsg. \_\_\_\_\_  
No. \_\_\_\_\_  
Sec. \_\_\_\_\_  
T. \_\_\_\_\_  
R. \_\_\_\_\_

Twp. 11 Pool 8E  
 Co. None Facet X

S-513-B

County Riley Elev. 1431 DC  
 Sec. 19 Twp. 11 Rge. 8E  
 Company Pure Oil  
 Farm Name F. R. McDermid No. 1

TOPS	DEPTH	LOG	DATUM
Anh.			
Tp. <u>Town</u> ?	<u>895</u>	<u>898</u>	
H. <u>Howard</u>	<u>1224</u>	<u>1221</u>	
Tr. <u>Toback</u> ?			
Dg. <u>Duvalne</u>	<u>1250</u>	<u>1252</u>	
B.L. <u>Brown</u> m	<u>1337</u>	<u>1341</u>	
L.	<u>1398</u>	<u>1403</u>	
K.C.			
B.K.C.	<u>1689</u>	<u>1693</u>	
Ce. <u>Mar</u> m	<u>1729</u>	<u>1732</u>	
C. <u>ce</u>	<u>1805</u>	<u>1804</u>	
M.			
M.			
K.	<u>1916</u>	<u>1914</u>	
Mz. <u>Hunt</u>	<u>2017</u>	<u>2018</u>	
Mq.			
V.			
S.			
S.		<u>2017</u>	
A.		<u>1916</u>	
R.		<u>1914</u>	
Pf.		<u>2017</u>	
G.			
T.D.	<u>2040</u>	<u>2090</u>	

Loc. in Sec. 1488' WL  
1650' SL  
 Geol. \_\_\_\_\_  
 Contr. \_\_\_\_\_  
Shira Drig  
 Pool \_\_\_\_\_  
Wildcat

**ABANDONED**  
 JUN 3 '58  
 0  
 JUN 3 '58

Date Comm. 5-31-58  
M I R WAY 28' 8" 157/120  $\phi$  1566  
JUN 3 '58 DST 1799-1855 1 1/2 2' m  
alp zero log

DOA

1693  
1331  
262

1914  
1693  
221