

KANSAS

Leavenworth

Sec. 19 Twp. 11 R. 22-E

Well No. #1 Fisher Farm

Roxana Oil Company


(Misc.)

 Ft. from N. Line

660 Ft. from S. Line

660 Ft. from E. Line

 Ft. from W. Line

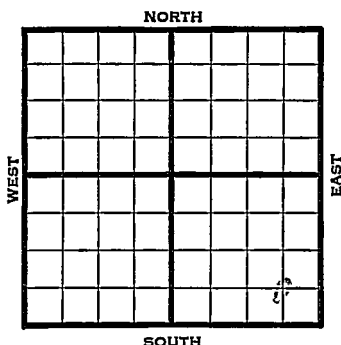

1941	REPORT
12/3	Machine.
	Drlg. 70'
12/11	Drlg. 648
12/18	8" @ 723 805 CD
12/24	Drlg. 1197'
12/31	Drlg. 1290'
1942	
1/8	SD 1300'
1/15	Drlg. 1325'
1/22	8" - 750' Miss. 1060'
	6" - 1300' Drlg. 1400'
1/29	B. Miss. 1645' Hunton 1690' 1490'
	Run casing.
2/5	Hunton 1490' (Corrected)
	SD for casing.
2/12	" " 16
2/19	Viola 1550'? 5" - 1550'
	Drlg. 1582'
	OVER

1490
1060

1942
2/25

Viola 1550'
5" - 1550'
T.D. 1630'
H.F.W.

ABANDONED

Leavenworth **KANSAS**Map No. MM Sec. 19 Twp. 11S R. 22EWell No. 1 FisherRoxana Oil CompanyFIRST REPORT Contractor

SECTION PLAT

C SE SE

 Ft. from N. Line660 Ft. from S. Line660 Ft. from E. Line Ft. from W. Line

			o

MISCELLANEOUS

Location Rig up

Drilling and Remarks:

MachineDrig. 70'

RECORD

Cased in., ft.Sand Gas Oil Total Depth

PRODUCTION

1st 24 hrs. Nat. 1st 24 hrs. after shot Gas Cu. Ft.Dry Hole Abandoned

Date

DEC 3 1941 19 S. J. LEWIS Scout

Misc Small Maps	
Cards	
Tracing	
France Map	
Scarborough Map	X
Moody Map	
Geological Dept.	
Moody Flat Book	

Leavenworth

Map No. MM Sec. 19 Twp. 11S R. 22EWell No. 1 Fisher

Roxana Oil

Company

ABANDONED

Contractor


C SE SE

SECTION FLAT

_____ Ft. from N. Line

660 Ft. from S. Line660 Ft. from E. Line

_____ Ft. from W. Line

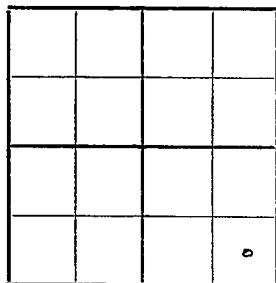

MISCELLANEOUS

Location _____

Rig up _____

Drilling and Remarks:

Vid 15505" @ 1550HFW.

RECORD

Cased _____ in., _____ ft.

Sand _____

Gas _____

Oil _____

Total Depth 1630

PRODUCTION

1st 24 hrs. Nat. _____

1st 24 hrs. after shot _____

Gas _____ Cu. Ft.

Dry Hole _____

Abandoned _____

Date

FEB 25 1942 19S. J. LEWIS Scout

LC

Misc. Small Maps	
Cards	
Tracing	
France Map	
Scarborough Map	
Moody Map	
Geological Dept.	
Moody Plat Book	