

KANSAS

FORM 51 5M 10-41 PETROL

Leavenworth

Section 20 Township 11 Range 22-E


Well No. ~~#1~~ ^{#2} O'Keefe

Company Roxan Oil

925

Wildcat

NORTH

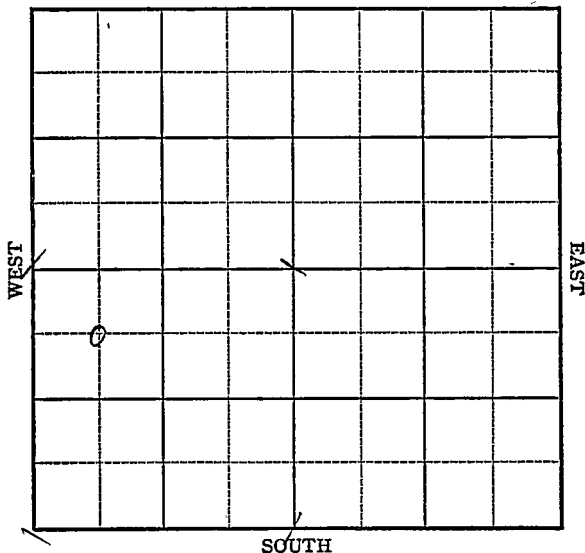

KANSAS

Leavenworth

Sec. 20 Twp. 11 R. 22-E

Well No. #2 #2 O'Keefe Farm

Roxan Oil Company


(Wildcat)

660 Ft. from N. Line

 Ft. from S. Line

 Ft. from E. Line

660 Ft. from W. Line

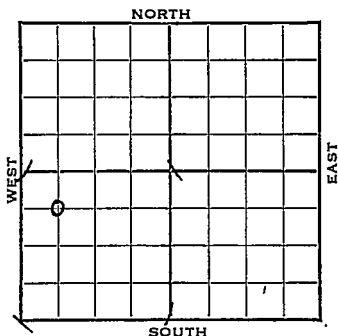

1942

REPORT

9/2 Drlg. 100'

9/9 Drlg 285 SD

9/16 Drlg 530

9/23 S.D. 580'

9/30 Drlg. 733'

10/7 6" - 657' T.D. 733' SD

10/14 Sand 657

6" - 657

1/2 M gas

T.D. 850

COMPLETED

COMPLETED

Leavenworth KANSAS

Map No. AM Sec. 20 Twp. 11 R. 22EWell No. 1 O'Keefe

Roxan Oil

Company

FIRST REPORT

Contractor

C NW SW


660 Ft. from N. Line

Ft. from S. Line

Ft. from E. Line

660 Ft. from W. Line

SECTION PLAT

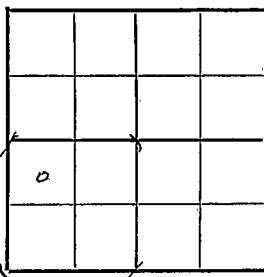

WILDCAT

Location

Rig up

Drilling and Remarks:

Drlg. 100'

RECORD

Cased _____ in., _____ ft.

Sand _____

Gas _____

Oil _____

Total Depth _____

PRODUCTION

1st 24 hrs. Nat. _____

1st 24 hrs. after shot _____

Gas _____ Cu. Ft.

Dry Hole _____

Abandoned _____

Date

SEP 2 1942

19

S. J. LEWIS Scout

Map No. MM Sec. 20 Twp. 11 R. 22EWell No. 2 O'KeefeRoxan Oil CompanyCORRECTION Contractor

C NW SW

660 Ft. from N. Line Ft. from S. Line Ft. from E. Line660 Ft. from W. Line

SECTION PLAT

o			

WILDCAT

Location Rig up

Drilling and Remarks:

Reported as

#1 O'Keefe

RECORD

Cased in., ft.Sand Gas Oil Total Depth

PRODUCTION

1st 24 hrs. Nat. 1st 24 hrs. after shot Gas Cu. Ft.Dry Hole Abandoned

Date

SEP 9 1942 19 S. J. LEWIS Scout

Map No. MM Sec. 20 Twp. 11 R. 22EWell No. 20 KeefeRoxan Oil


Company

COMPLETED

Contractor

C NW SW

SECTION PLAT

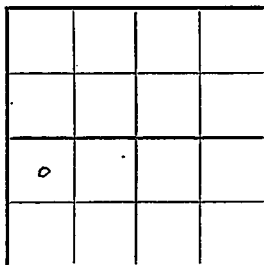660 Ft. from N. Line Ft. from S. Line Ft. from E. Line660 Ft. from W. Line

WILDCAT

Location Rig up

Drilling and Remarks:

Sanol 6576" @ 6571/2 M Gas

RECORD

Cased in., ft.Sand Gas Oil Total Depth 150

PRODUCTION

1st 24 hrs. Nat. 1st 24 hrs. after shot Gas Cu. Ft.Dry Hole Abandoned

Date

OCT 14 1942

19

S. J. LEWIS

Scout