

MISSOURI GEOLOGICAL SURVEY AND WATER RESOURCES
ROLLA, MISSOURI

COUNTY Leavenworth Kans LOG NUMBER _____

COMPANY OR OWNER Pleasant Valley School

FARM _____ WELL NO. _____

LOCATION SW SW NW SEC. 35 T. 11S R. 21E


CONTRACTOR Cullum & Brown Inc

DRILLER R A Barnes TOOL DR. 0

COMMENCED _____ COMPLETED 1949

PRODUCTION _____ PLOTTED _____

CASING RECORD 33 1/4 6 1/4

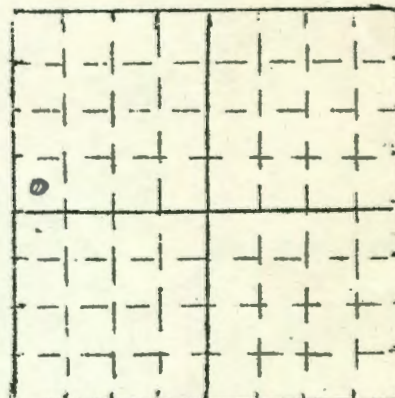

WATER RECORD _____

SOURCE OF LOG Driller's original

REMARKS _____

REMARKS _____

ELEV. _____

TOTAL DEPTH 110

FORMATION

: THICK. : DEPTH :

FORMATION

: THICK. : DEPTH :

Sand clay yellow : 0 : 12 :
Clay sandy " : 12 : 25 :
Sand and brown : 25 : 29 :
" : 29 : 46 :
Shale gray : 46 : 50 :
Shale slate black : 50 : 52 :
" : 52 : 58 :
Shale gray : 58 : 62 :
Lamin sandy band : 62 : 64 :
Sand : 64 : 73 :
Shale gray : 73 : 76 :
" : 76 : 94 :
Shale gray : 94 : 95 :
" : 95 : 103 :
Sand : 103 : 108 :
" : 108 : 110 :

Start

CC

water

Plattsburg

water

TD