


Section 21 Township 11 Range 22-E

Well No. #1 Schubert

Company McLaughlin etal 973

Miscellaneous

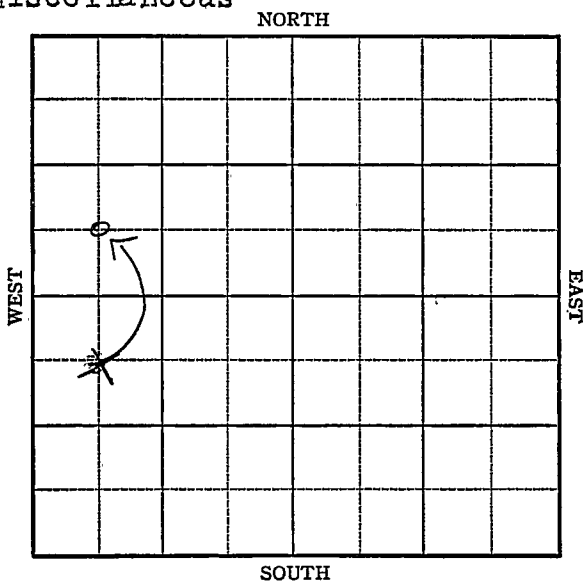

KANSAS

Leavenworth

Form 252-A
5M 5-42 PetrolSec. 21 Twp. 11 R. 22-EWell No. #1 Schubert FarmMcLaughlin et al Company


(Miscellaneous)

~~660~~ Ft. from N. Line660 Ft. from S. Line

Ft. from E. Line

660~~660~~

Ft. from W. Line

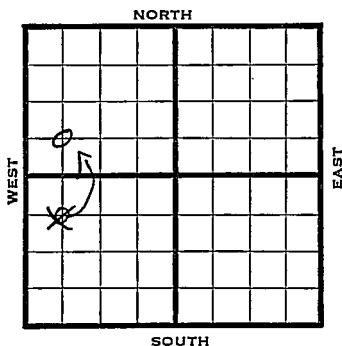

1942

REPORT

9/9

155' Shut down.

9/16

388 SD

9/23

"

9/30

TD 905 Abandoned

ABANDONED

Map No. VM Sec. 21 Twp. 11 R. 22EWell No. 1 SchubertMcLaughlin etal. Company**FIRST REPORT** Contractor

C NW SW

660 Ft. from N. Line Ft. from S. Line Ft. from E. Line660 Ft. from W. Line

SECTION PLAT

MISCELLANEOUS

Location Rig up

Drilling and Remarks:

155' Shut Down

RECORD

Cased in., ft.Sand Gas Oil Total Depth

PRODUCTION

1st 24 hrs. Nat. 1st 24 hrs. after shot Gas Cu. Ft.Dry Hole Abandoned

Date

SEP 9 1942 19S. J. LEWIS Scout

Leavenworth

Map No. MM Sec. 21 Twp. 11 R. 22EWell No. 1 SchubertMcLaughlin et al. CompanyCORRECTION Contractor

C SW NW

SECTION PLAT

o			

 Ft. from N. Line660 Ft. from S. Line Ft. from E. Line660 Ft. from W. Line

MISCELLANEOUS

Location Rig up

Drilling and Remarks:

Reported
C NW SW

RECORD

Cased in., ft.Sand Gas Oil Total Depth

PRODUCTION

1st 24 hrs. Nat. 1st 24 hrs. after shot Gas Cu. Ft.Dry Hole Abandoned

Date

SEP 16 1942 19S. J. LEWIS Scout

KANSAS

Leavenworth

Map No. MM Sec. 21 Twp. 11 R. 22EWell No. 1 SchubertMcLaughlin et al. Company

Contractor

C SW NW

SECTION PLAT

●			

Ft. from N. Line

660

Ft. from S. Line

Ft. from E. Line

660

Ft. from W. Line

MISCELLANEOUS

Location _____

Rig up _____

Drilling and Remarks:

Aband

RECORD

Cased _____ in., _____ ft.

Sand _____

Gas _____

Oil _____

Total Depth 905

PRODUCTION

1st 24 hrs. Nat. _____

1st 24 hrs. after shot _____

Gas _____ Cu. Ft.

Dry Hole _____

Abandoned _____

Date ABANDONEDSEP 30 1942 19S. J. LEWIS Scout