

KANSAS

Lavenworth


FORM 51 5M 10-41 PETROL

Section 22 Township 11-S Range 21-E

Well No. 1 J. C. Lanning

Company Ryan Consolidated

Miscellaneous

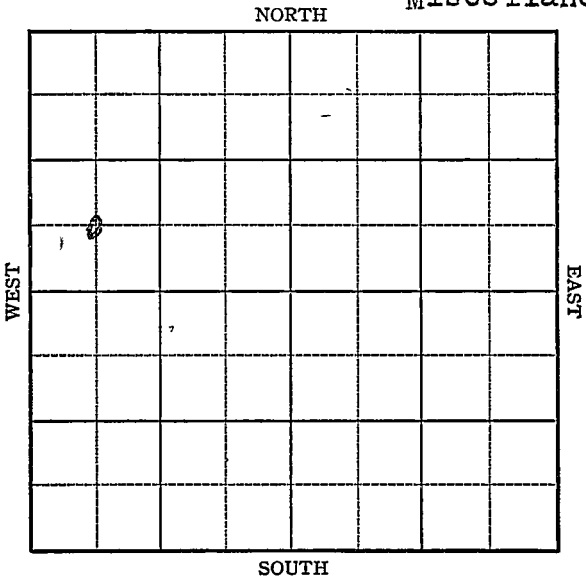


KANSAS

Leavenworth

Sec. 22 Twp. 11 R. 21-EWell No. #1 J. C. Lanning FarmRyan Consolidated Company

(Misc.)

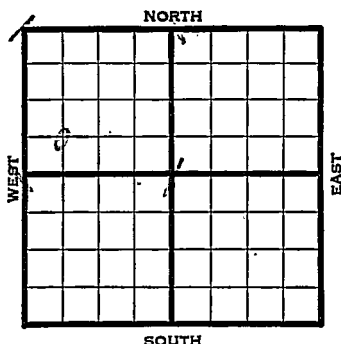 Ft. from N. Line660 Ft. from S. Line Ft. from E. Line660 Ft. from W. Line*Elev 953*

1941	REPORT
12/3	Location
12/11	"
12/18	"
12/24	Machine.
12/31	Spud.
1942	
1/8	SD 100'
1/15	Drlg. 130'
1/22	SD 130'
1/29	Drlg. 1000'
2/5	SD 1248'
2/12	10" - 1250' Miss. 1250'
	Drlg. 1467'
2/19	B. Miss. 1625' Hunton 1681' T.D.
2/26	" " "
3/5	Drlg. 1880'
3/12	No report.
3/19	" "
	OVER

*1681
1250
431*

Map No. MM Sec. 22 Twp. 11S R. 21EWell No. 1 J. C. LanningRyan Consolidated Company**ABANDONED**

Contractor

C SW NW

SECTION PLAT

o			

 Ft. from N. Line660 Ft. from S. Line Ft. from E. Line660 Ft. from W. Line

MISCELLANEOUS

Location Rig up

Drilling and Remarks:

*Miss 1240**Huntow 1681**Vila 1775**Cr 81963**HPH.*

RECORD

Cased in., ft.Sand Gas Oil Total Depth 2033

PRODUCTION

1st 24 hrs. Nat. 1st 24 hrs. after shot Gas Cu. Ft.Dry Hole Abandoned

Date

MAR 25 1942 19S. J. LEWIS

Scout


Leavenworth

KANSASMap No. MM Sec. 22 Twp. 11S R. 21EWell No. 1 J. C. LanningRyan Consolidated CompanyFIRST REPORT Contractor

C SW NW

 Ft. from N. Line660 Ft. from S. Line Ft. from E. Line660 Ft. from W. Line

SECTION PLAT

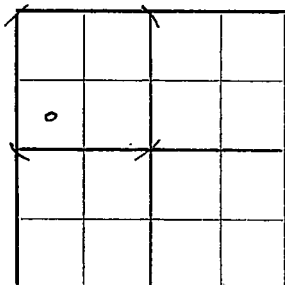

MISCELLANEOUS

Location XXRig up

Drilling and Remarks:

RECORD

Cased in., ft.Sand Gas Oil Total Depth

PRODUCTION

1st 24 hrs. Nat. 1st 24 hrs. after shot Gas Cu. Ft.Dry Hole Abandoned

Date

DEC 3 1941 19 S. J. LEWIS Scout