


Section 29 Township 11 Range 22-E

Well No. #1 Reiger Est.

Company Roxan Oil

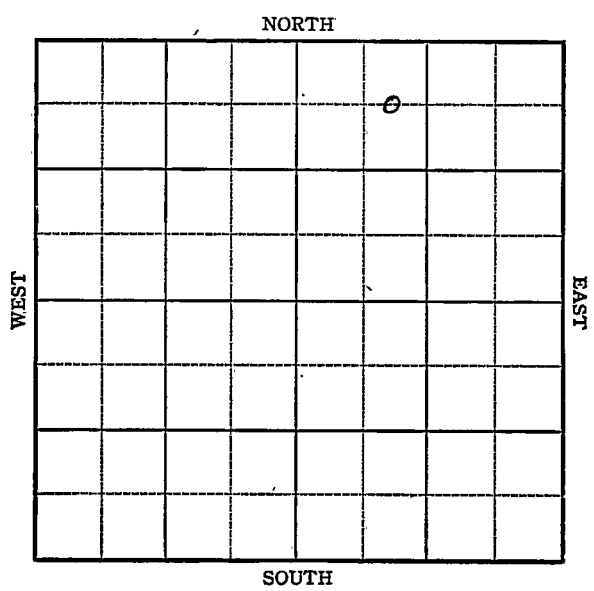


Sec. 29 Twp. 11 R. 22-E

Well No. #1 Reiger Est. Farm

Roxan Oil Company

660 Ft. from N. Line  
 \_\_\_\_\_ Ft. from S. Line  
 \_\_\_\_\_ Ft. from E. Line  
990 Ft. from W. Line

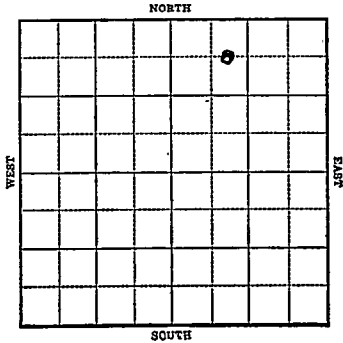

1943

R E P O R T

9/15 Machine  
 9/22 "  
 9/29 Sand 795'  
 5" @ 805  
 1/4 M Gas  
 T.D. 809'

**COMPLETED**

**KANSAS**

Map No. NM Sec. 29 Twp. 17 R. 22E

Well No. 1 Reiger Est.

Roxan Oil Company

**FIRST REPORT** Contractor

C E L NW NE

**SECTION PLAT**

660 Ft. from N. Line

\_\_\_\_\_ Ft. from S. Line

\_\_\_\_\_ Ft. from E. Line

990 Ft. from W. Line


McLouth Pool

Location \_\_\_\_\_

Rig up \_\_\_\_\_

Drilling and Remarks:

Machine

**RECORD**

Cased \_\_\_\_\_ in., \_\_\_\_\_ ft.

Sand \_\_\_\_\_

Gas \_\_\_\_\_

Oil \_\_\_\_\_

Total Depth \_\_\_\_\_

**PRODUCTION**

1st 24 hrs. Nat. \_\_\_\_\_

1st 24 hrs. after shot \_\_\_\_\_

Gas \_\_\_\_\_ Cu. Ft.

Dry Hole \_\_\_\_\_

Abandoned \_\_\_\_\_

Date

SEP 15 1943

19

S. J. LEWIS Scout

**KANSAS**

Map No. 11M Sec. 29 Twp. 11 R. 22E

Well No. 1 Reiger Est.

Roxon Oil Company

**COMPLETED** Contractor

C E L N W N E

660 Ft. from N. Line

\_\_\_\_\_ Ft. from S. Line

\_\_\_\_\_ Ft. from E. Line

990 Ft. from W. Line

**SECTION PLAT**

		o	

**McLouth Pool**

Location \_\_\_\_\_

Rig up \_\_\_\_\_

Drilling and Remarks:

Machine

*Sand 795.*

*5" @ 805.*

*1/4" Gas*

**RECORD**

Cased \_\_\_\_\_ in., \_\_\_\_\_ ft.

Sand \_\_\_\_\_

Gas \_\_\_\_\_

Oil \_\_\_\_\_

Total Depth 809

**PRODUCTION**

1st 24 hrs. Nat. \_\_\_\_\_

1st 24 hrs. after shot \_\_\_\_\_

Gas \_\_\_\_\_ Cu. Ft.

Dry Hole \_\_\_\_\_

Abandoned \_\_\_\_\_

Date

SEP 29 1943 19

**S. J. LEWIS** Scout