S. 26 T. 11S R. 8 E W


DRILLERS LOG

Loc. S/2 NW NE

API No. 15 – 161 (County) – 20,053 (Number)

County Riley

640 Acres

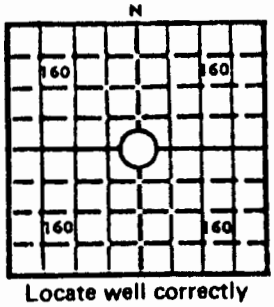

Locate well correctly

Operator
Brandt Production Company

Address
105 S. Broadway, Suite 920, Wichita, Kansas 67202

Well No.	Lease Name
7	Yaege

Footage Location
4280 feet from (N) (S) line 1980 feet from (E) (W) line

Principal Contractor	Geologist
Glacier Drilling Company, Inc.	Earl Brandt

Spud Date	Total Depth	P.B.T.D.
9-20-85	1,632'	1,710'

Date Completed	Oil Purchaser
9-24-85	

Elev.: Gr. 1,300'

DF _____ KB _____

CASING RECORD

Report of all strings set—surface, intermediate, production, etc.

Purpose of string	Size hole drilled	Size casing set (in O.D.)	Weight lbs/ft.	Setting depth	Type cement	Sacks	Type and percent additives
SURFACE	12-1/4"	8-5/8"		316'	Common	190	3% cc
PRODUCTION							

WELL LOG

Show all important zones of porosity and contents thereof; cored intervals, and all drill-stem tests, including depth interval tested, cushion used, time tool open, flowing and shut-in pressures, and recoveries.

Formation	Top	Btm.
Top soil	0	5
Lime	5	38
Shale w/lime	38	157
Shale	157	380
ale & lime	380	448
Shale	448	649
Lime w/shale	649	681
Shale	681	725
me	725	737
Shale w/lime	737	789
Lime	789	848
Shale w/lm stks	848	914
Heebner	914	949
Shale	949	1108
Lansing	1108	1512
Shale	1512	1565
Hunton	1565	1632 RTD

Formation	Top	Btm.

Formation	Top	Btm.

RECEIVED
STATE CORPORATION COMMISSION
NOV 12 1985
CONSERVATION DIVISION
Wichita, Kansas

MISCH—COFFEYVILLE