SIDE ONE

26-11-8E

**STATE CORPORATION COMMISSION OF KANSAS**
**OIL & GAS CONSERVATION DIVISION**
**WELL COMPLETION OR RECOMPLETION FORM**
**ACO-1 WELL HISTORY**
**DESCRIPTION OF WELL AND LEASE**

API NO. 15-161-20060

County: Riley

NE/4 SE/4 SE/4 Sec. 26 Twp. 11S Rge. 8 X East ___ West

990 Ft North from Southeast Corner of Section
330 Ft West from Southeast Corner of Section
**(Note: Locate well in section plat below)**

Lease Name: Yaege A Well #: 26

Field Name: Yaege

Producing Formation: Hunton

Elevation: Ground 1405 KB 1410

**Section Plat**

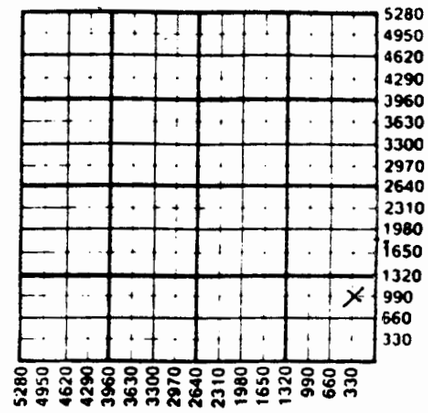


**Operator: License #** 5447
Name: OXY USA Inc.
Address: P. O. Box 26100
Oklahoma City, OK 73126-0100
City/State/Zip

**Purchaser:** CITGO

**Operator Contact Person:** Raymond Hui
Phone: (405) 749-2471

**Contractor: License #** 5825
Name: Glacier Drilling Company

**Wellsite Geologist:** Paul Ramondetta
Phone: (405) 749-2000

Designate **Type of Completion**
X New Well ___ Re-Entry ___ Workover

X Oil ___ SWD ___ Temp Abd
___ Gas ___ Inj ___ Delayed Comp.
___ Dry ___ Other (Core, Water Supply etc.)

If OWWO: old well info as follows:
Operator
Well Name
Comp. Date ..... Old Total Depth

RECEIVED
STATE CORPORATION COMMISSION
JAN 19 1989
CONSERVATION DIVISION
Wichita, Kansas

**WELL HISTORY**

Drilling Method:
X Mud Rotary ___ Air Rotary ___ Cable

| 11-8-1988 | 11-14-1988 | 12-9-1988 |
|---|---|---|
| Spud Date | Date Reached TD | Completion Date |

| 1890 | 1834' |
|---|---|
| Total Depth | PBTD |

Amount of Surface Pipe Set and Cemented at 306 feet
Multiple Stage Cementing Collar Used? ___ Yes X No
If yes, show depth set ..... feet
If alternate 2 completion, cement circulated
from ..... feet depth to ..... w/ ..... SX cmt
Cement Company Name
Invoice #

**WATER SUPPLY INFORMATION**

**Disposition of Produced Water:** ___ **Disposal**
**Docket #** ___ **Repressuring**

**Questions on this portion of the ACO-1 call:**
**Water Resources Board (913) 296-3717**

Source of Water: Provided by Driller
Division of Water Resources Permit #

___ Groundwater ..... Ft North from Southeast Corner
(Well) ..... Ft West from Southeast Corner of
Sec Twp Rge ___ East ___ West

___ Surface Water ..... Ft North from Southeast Corner
(Stream, pond etc) ..... Ft West from Southeast Corner
Sec Twp Rge ___ East ___ West

___ Other (explain)
(purchased from city, R.W.D. #)

INSTRUCTIONS: This form shall be completed in triplicate and filed with the Kansas Corporation Commission, 200 Colorado Derby Building, Wichita, Kansas 67202, within 120 days of the spud date of any well. Rule 82-3-130, 82-3-107 and 82-3-106 apply.
Information on side two of this form will be held confidential for a period of 12 months if requested in writing and submitted with the form. See rule 82-3-107 for confidentiality in excess of 12 months.
One copy of all wireline logs and drillers time log shall be attached with this form. Submit CP-4 form with all plugged wells. Submit CP-111 form with all temporarily abandoned wells.

All requirements of the statutes, rules and regulations promulgated to regulate the oil and gas industry have been fully complied with and the statements herein are complete and correct to the best of my knowledge.

Signature: Bryan Humphries

Title: Engineering Manager Date 1-12-1989

Subscribed and sworn to before me this 12th day of January 1989.
Notary Public: Marsha G. Carlson

Date Commission Expires: 4-1-92

**K.C.C. OFFICE USE ONLY**
F ✓ Letter of Confidentiality Attached
C ✓ Wireline Log Received
C ___ Drillers Timelog Received

**Distribution**
___ KCC ___ SWD/Rep ___ NGPA
✓ KGS ___ Plug ___ Other (Specify)

Form ACO-1 (5-86)

JAN 21 1989
KANSAS GEOLOGICAL SURVEY
WICHITA BRANCH