


(C. B. Cox)
 Farm
Leavenworth
 County
Nine Mile Ranch No. _____
 Farm

Company _____

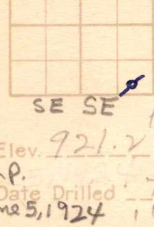

Twp.


6	5	4	3	2	1
7	8	9	10	11	12
18	17	16	15	14	13
19	20	21	22	23	24
30	29	28	27	26	25
31	32	33	34	35	36

Elev. 921.2 Kerly 17 T.D. 775

Comp. _____
 Date Drilled June 5, 1924 700 n of Stone
150 w of L Line
 Correlation by _____

From - T. M. Galey

10" Casing 12'
 8" " 188'
 6 1/4" " 700'

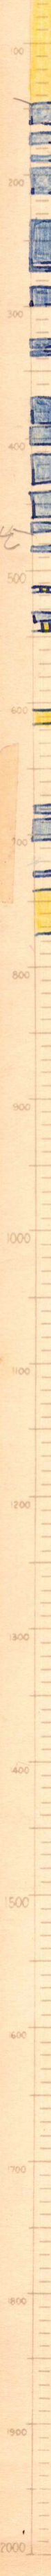

Water

Tola

Hertha

921
 470
 446

Water

Gas } show
 oil }