


Wabaunsee

Form 51-5M-2-29-84703

Map No. **KANSAS** Sec. 9 Twp. 12 R. 10  
Well No. 1-"B" Sheets Soleman et al Farm Company

NORTH

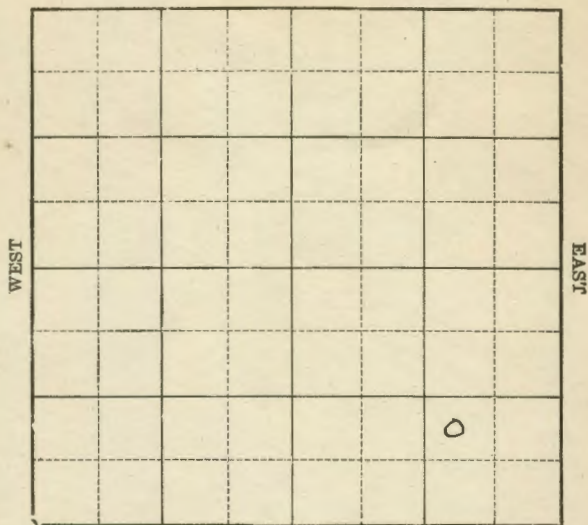

SOUTH

Location  
Drilling Remarks

Rig Up  
Drilling Remarks

RECORD

Cased \_\_\_\_\_ in. \_\_\_\_\_ ft.  
Sand \_\_\_\_\_  
Gas \_\_\_\_\_  
Oil \_\_\_\_\_  
Total Depth \_\_\_\_\_

PRODUCTION


1st 24 hrs. Nat. \_\_\_\_\_  
1st 24 hrs. after shot \_\_\_\_\_  
Gas \_\_\_\_\_ cu. ft. \_\_\_\_\_  
Dry Hole \_\_\_\_\_  
Abandoned \_\_\_\_\_

Wabaunsee

FORM 252A-5M-12-28-PETROL

Map No. **KANSAS** Sec. 9 Twp. 12 R. 10<sup>E</sup>  
Well No. 1-"B" Smith Soleman et al Farm Company

NORTH

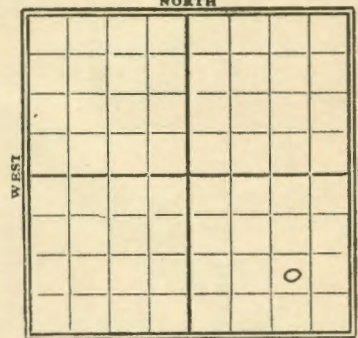

SOUTH

\_\_\_\_\_ Ft. from N. Line

1005 Ft. from S. Line

1000 Ft. from E. Line

\_\_\_\_\_ Ft. from W. Line

1929

Date

REPORT

3/27 sand 265-267'  
T.D. 267'  
38,000 cu. ft. of  
Helium gas  
Completed

Warrenssee

KANSAS

Map No. *norman B* Sec. *9* Twp. *12* R. *10 E*Well No. *Smith**Coleman* *Catal* Company

Contractor

FIRST REPORTS

COMPLETE

SECTION PLAT

|  |  |  |   |
|--|--|--|---|
|  |  |  |   |
|  |  |  |   |
|  |  |  |   |
|  |  |  | 0 |

Ft. from N. Line

*1005* Ft. from S. Line*1000* Ft. from E. Line

Ft. from W. Line

Location *NW SE SE*

RECORD

Cased *in.* *ft.*Sand *265-267*

Gas

Oil

Total Depth *267*

PRODUCTION

1st 24 hrs. Nat.

1st 24 hrs. after shot

Gas *Cu. Ft.*

Dry Hole

Abandoned

*38,000 cubic  
feet helium gas*

Date

MAR 27 1929

192

CHAS. L. SHERWOOD

Scout