

Sec. 30 Twp. 12 S Range 10 E

#12-W Browning Unit Tr. "D"

Kansas Geological Society
(Browning Unit Wtr. Flood)

Skelly Scout Tickets

Sinclair

HOT FILE Greenwood **KANSAS**

SEC. 30 TWP. 12 S R. 10 E

WELL NO. # 12-W Browning Unit Tr. "D" FARM

COMPANY Sinclair (DEVELOPMENT-OBG)

CONTRACTOR

Browning Field.

660 FT. FROM N. LINE


FT. FROM S. LINE

1315 FT. FROM E. LINE

FT. FROM W. LINE

of NE/4

C N/2 NE/4

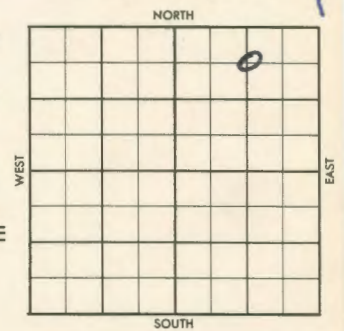

	ELEVATION	REPORT
1956		
9/25	2600'	Bartlesville Test Spudded 9-17-56 Drlg. 1790' (DR#187)
9/26	Drlg. 2115'	
9/27	TD 2470'	Rng. EL
9/28	TD 2470'	WOC - 5 1/2" @ 2426'
10/1	TD 2470'	WOC - 5 1/2" csg.
10/2	TD 2470'	" "
10/3	TD 2470'	" "
10/4	"	" "
10/5	TD 2470'	" "
10/8	TD 2470'	" "
10/9	TD 2470'	" "
10/10	TD 2470'	" "
10/11	TD 2470'	" "
10/12	TD 2470'	" "
10/15	TD 2470'	" "
10/16	"	" "
10/17	TD 2470'	" "
10/18	"	" "
10/19	TD 2470'	" "
10/22	TD 2470'	" "
10/23	TD 2470'	Drlg. plug.

529558

956
~~2/24~~
0/24 TD 2470'. Drlg. plug.
0/25 TD 2470'. Cleaning out.
0/26 TD 2470' "
0/29 TD 2470'. **Water Injection Well**
Open hole 2426-2470'. Bartlesville
Zone. **Complete** (DR#211)

COMPLETED