


15-197-00091

KANSAS

Section 20 Township 12 Range 10EWell No. #1 PolenskeCompany Musgrove Pet. et al

NORTH

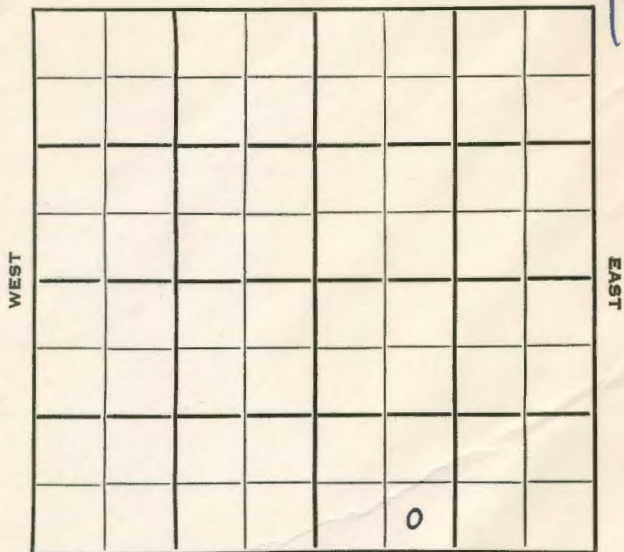

SOUTH

Waubaunsee

KANSAS

SEC.	TWP.	R.
20	12	10E ✓

WELL NO.

#1 Polenske

FARM

COMPANY

Musgrove Pet. et al

CONTRACTOR

Ft. from N. Line

330


Ft. from S. Line

Ft. from E. Line

990

Ft. from W. Line

NORTH

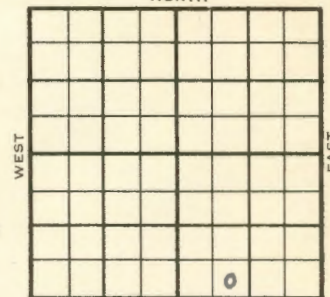

SOUTH

SE SW SE
Phillips DHM & AC.

ELEVATION

REPORT

1954

1075'

3/2

Spud 2-28-54
8" @ 145'

3/31

Spud 2-28-54

D & A

TD 3280'

8" @ 145'

Heeb 1052', Lans 1263', KC 1402',
Cherokee 1846', Burg. 2226', Miss 2231'
Viola 3042', Simp 3135', Arb 3247'

TD 3280'

D & A

ABANDONED

County **Waubaussee** State **Kansas**
 Sec. **20** (Blk. **12** (Sur. **10E** Map No.
 Operator **Musgrove Pet. etal.**
 Well No. **1** Farm **Polenske**
 Elev. Location **SE SW SE**

330 Ft. From **S** Line **SE**
990 Ft. From **W** Line Quarter

1st. Report **MAR 3 1954**

Completion

Remarks **Phillips DHM & AC**

Spudding Date **2-28-54**

Drig. Data

8" @ 145

J. G. McGEHEE

County **Waubaussee** State **Kansas**
 Sec. **20** (Blk. **12** (Sur. **10E** Map No.
 Operator **Musgrove Pet. etal.**
 Well No. **1** Farm **Polenske**
 Elev. **1075** Location **SE SW SE**

330 Ft. From **S** Line **SE**

990 Ft. From **W** Line Quarter

1st. Report

Completion **MAR 3 1 1954**

Remarks

Spudding Date **2-28-54**

Drig. Data **D & A TD 3280**

8" @ 145 Heeb. 1052 Lans. 1263

KC 1402 Cherokee 1846 Burg. 2226

Miss. 2231 Viola 3042 Simp. 3135

Arb. 3247 TD 3280

D & A

J. G. McGEHEE