


15-197-00092

KANSAS

Section 23 Township 12 Range 10EWell No. #1 ZeckserCompany Musgrove Pet. et al

NORTH

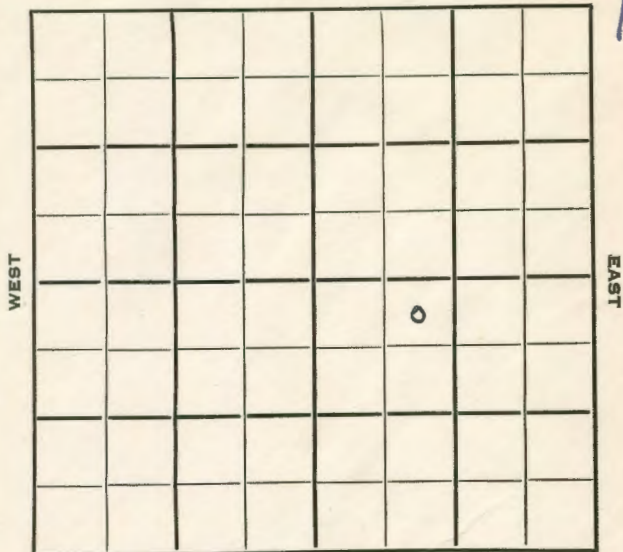

SOUTH

Waubaussee

KANSAS

SEC. 23 TWP. 12 R. 10E ✓

WELL NO.

#1 Zeckser

FARM

COMPANY

Musgrove Pet. et al

CONTRACTOR

Musgrove

Wildcat.

330

Ft. from N. Line


Ft. from S. Line

Ft. from E. Line

990

Ft. from W. Line

NORTH

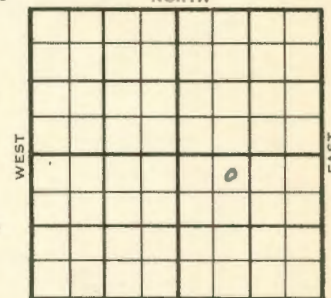

SOUTH

NE NW SE

Phillips DUM & AC.

1954

ELEVATION

1144'

REPORT

3/2

Spud 3-1-54

Drlg. 45

4/14

Spud 3-1-54

D & A

TD 3330'

8" @ 144'

Heeb 1071', Lans 1296', KC 1442'

B KC 1655', Cherokee 1874' Miss 2322'

Kh. 2607', Hunton 2804'

DST 2806'-18' opn 1 hr, rec 120' sw

15' ocs w 1080# Maq. 3025' Viola

3093' Simp 3198', Arb 3299'

TD 3330'

Schlumberger Tops: Heeb 1072' Lans

1296', KC 1443', B KC 1658', Cherokee

1874', Miss 2319', Kh. 2610', Hunton

2805', Maq. 3024' Viola 3099', Simp

3187', St. Peter 3222' Arb 3298'

TD 3330'

D & A

$$\begin{array}{r} 1296 \\ 1144 \\ \hline 152 \end{array}$$

$$\begin{array}{r} 2322 \\ 1296 \\ \hline 1026 \end{array}$$

ABANDONED

$$\begin{array}{r} 2322 \\ 1655 \\ \hline 667 \end{array}$$

County **Waubaussee** State **Kansas**
 Sec. **25** (Blk. **12** (Sur. **10E** Map No.
 Operator **Musgrove Pet. etal.**
 Well No. **1** Farm **Zeckser**
 Elev. Location **NE NW SE**
 330 Ft. From **N** Line **SE**
 990 Ft. From **W** Line Quarter
 Ist. Report **MAR 3 1954**
 Completion
 Remarks **Phillips IHM & AO**
Musgrove - Contr.
 Spudding Date **3-1-54**
 Drlg. Data **Wildcat**

FIRST REPORT

drlg. 45

J. G. McGEHEE

County **Waubaussee** State **Kansas**
 Sec. **23** (Blk. **12** (Sur. **10E** Map No.
 Operator **Musgrove Pet. etal.**
 Well No. **1** Farm **Zeckser**
 Elev. **1144** Location **NE NW SE**
 330 Ft. From **N** Line **SE**
 990 Ft. From **W** Line Quarter
 Ist. Report
 Completion **APR 14 1954**
 Remarks **Wildcat**
Musgrove - Contr.
 Spudding Date **3-1-54**
 Drlg. Data **D & A TD 3330**

ABANDONED

8" @ 144 Heeb. 1071 Lans. 1296
 KC 1442 B KC 1655 Cherokee 1874
 Miss. 2322 Kh. 2607 Hunton 2804
 DST 2806-18 open 1 hr. Rec. 120' sw
 15' ocs w 1080# Mag. 3025 Viola 3093
 Simp. 3198 Arb. 3299 TD 3330
 SCHLUMBERGER TOPS:
 Heeb. 1072 Lans. 1296 KC 1443
 B KC 1658 Cherokee 1874 Miss. 2319
 Kh. 2610 Hunton 2809 Mag. 3024
 Viola 3099 Simp. 3187 St. Peter 3222
 Arb. 3298 TD 3330

D & A

J. G. McGEHEE